
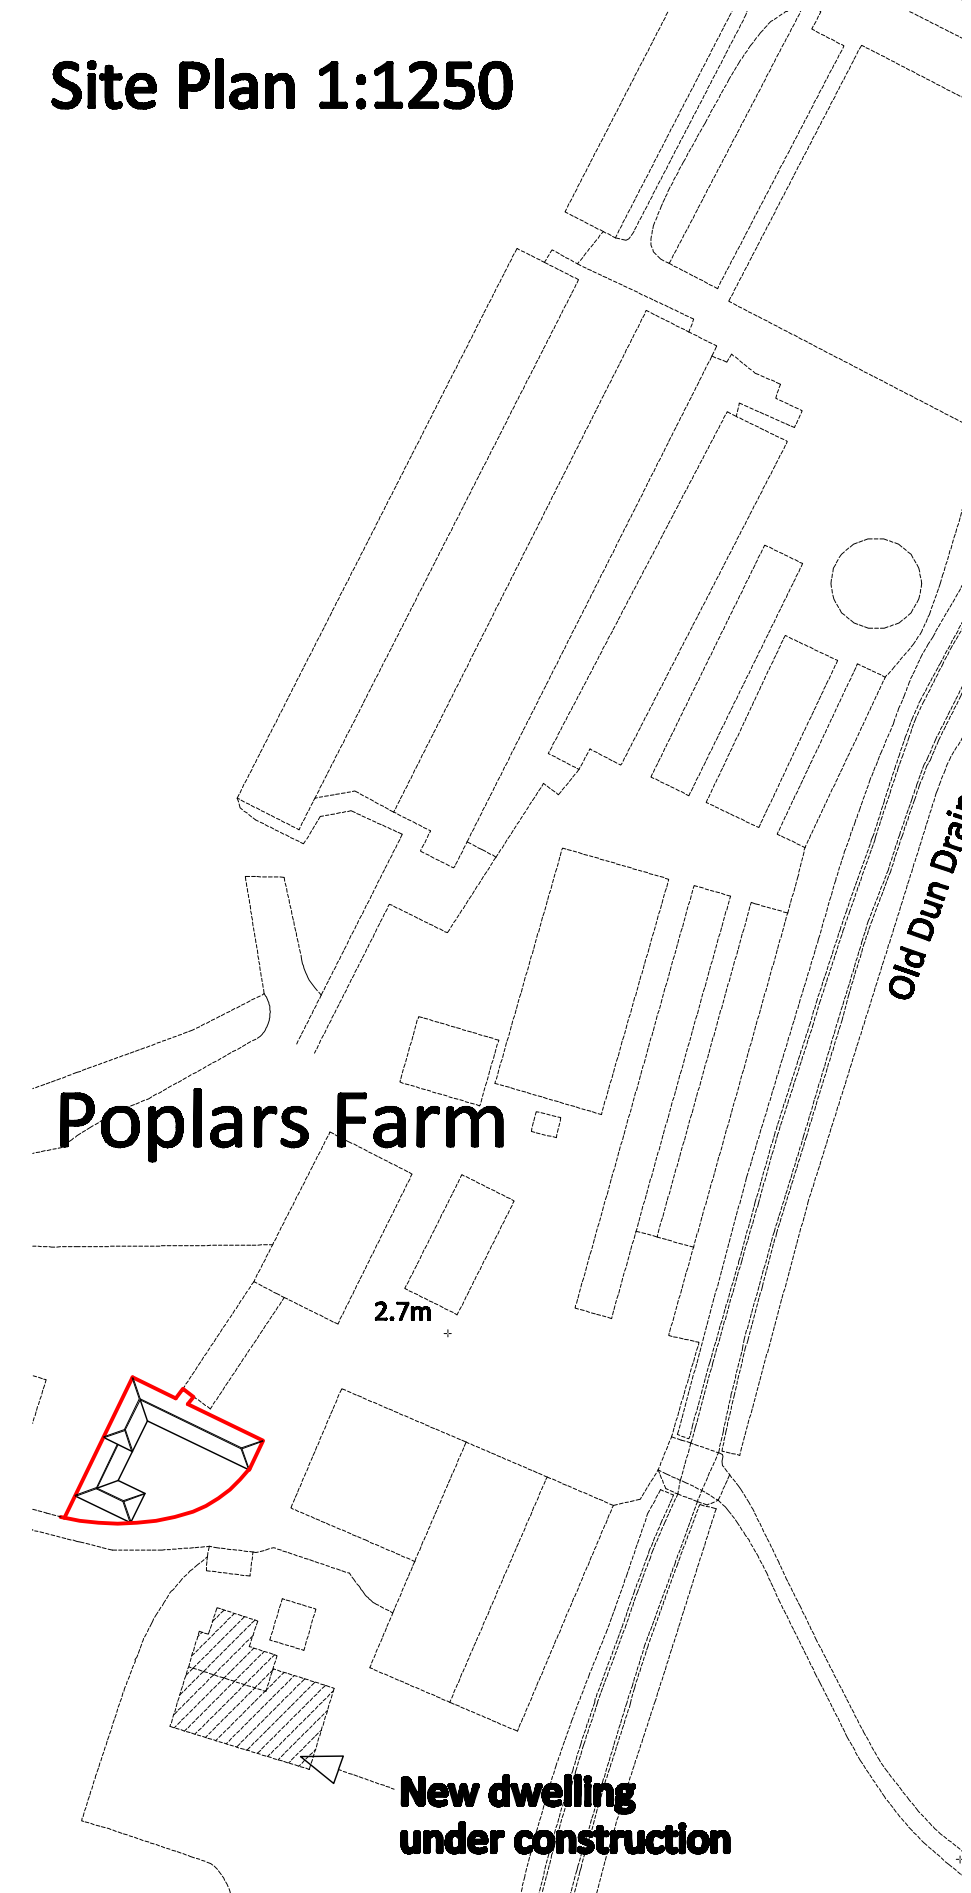


Block Plan 1:500

8/2/12

Site Plan 1:1250

Poplars Farm

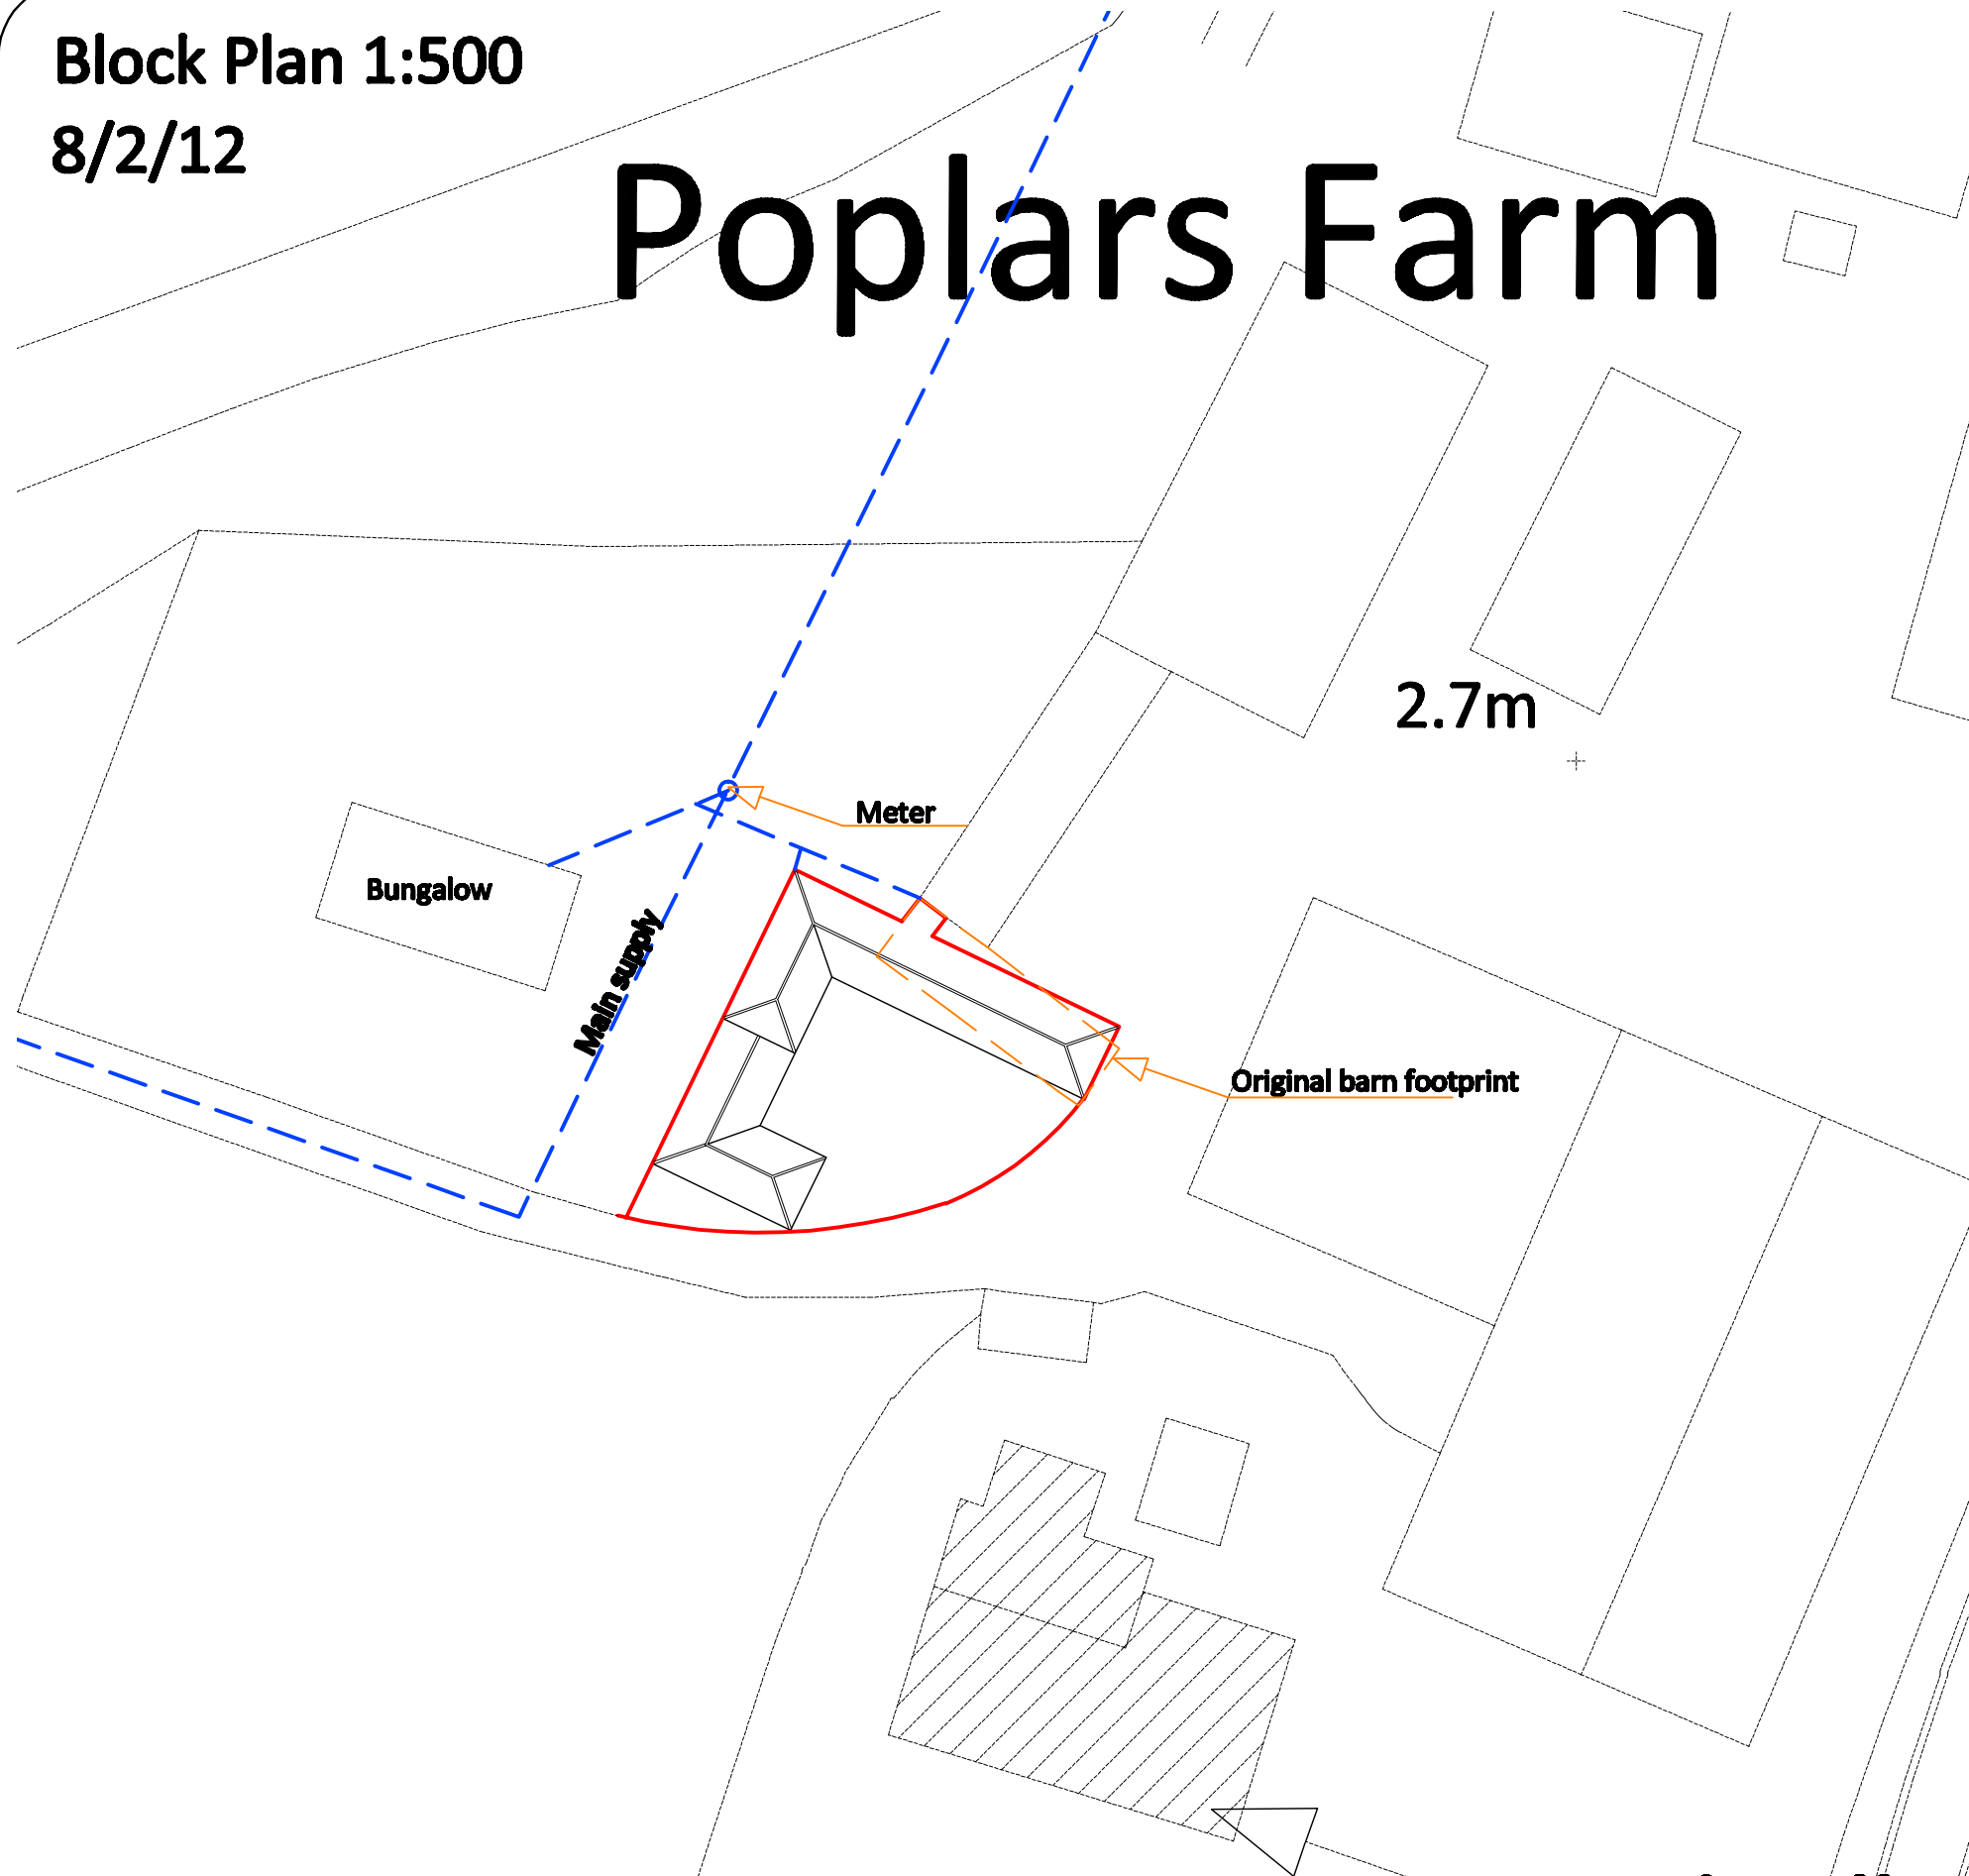

Howard J Wroot BSc MRICS
Chartered Surveyor
240 Wharf Road, Ealand
Scunthorpe DN17 4JN

Tel 01724 711068
Fax 01724 710174
Mob 07947 226577

Client	H Barker & Sons		
Date	18/12/11	Dwg No	2 of 3
Scale	As noted	Ref No	804 Barn

Proposal
Drawing

Retain Barn as Built, Polars Farm
Crowle, Scunthorpe, DN17 4BN
Block Plan and Site Plan

