


site location plan
scale 1:1250
license no: 100048957



proposed block plan
scale 1:500

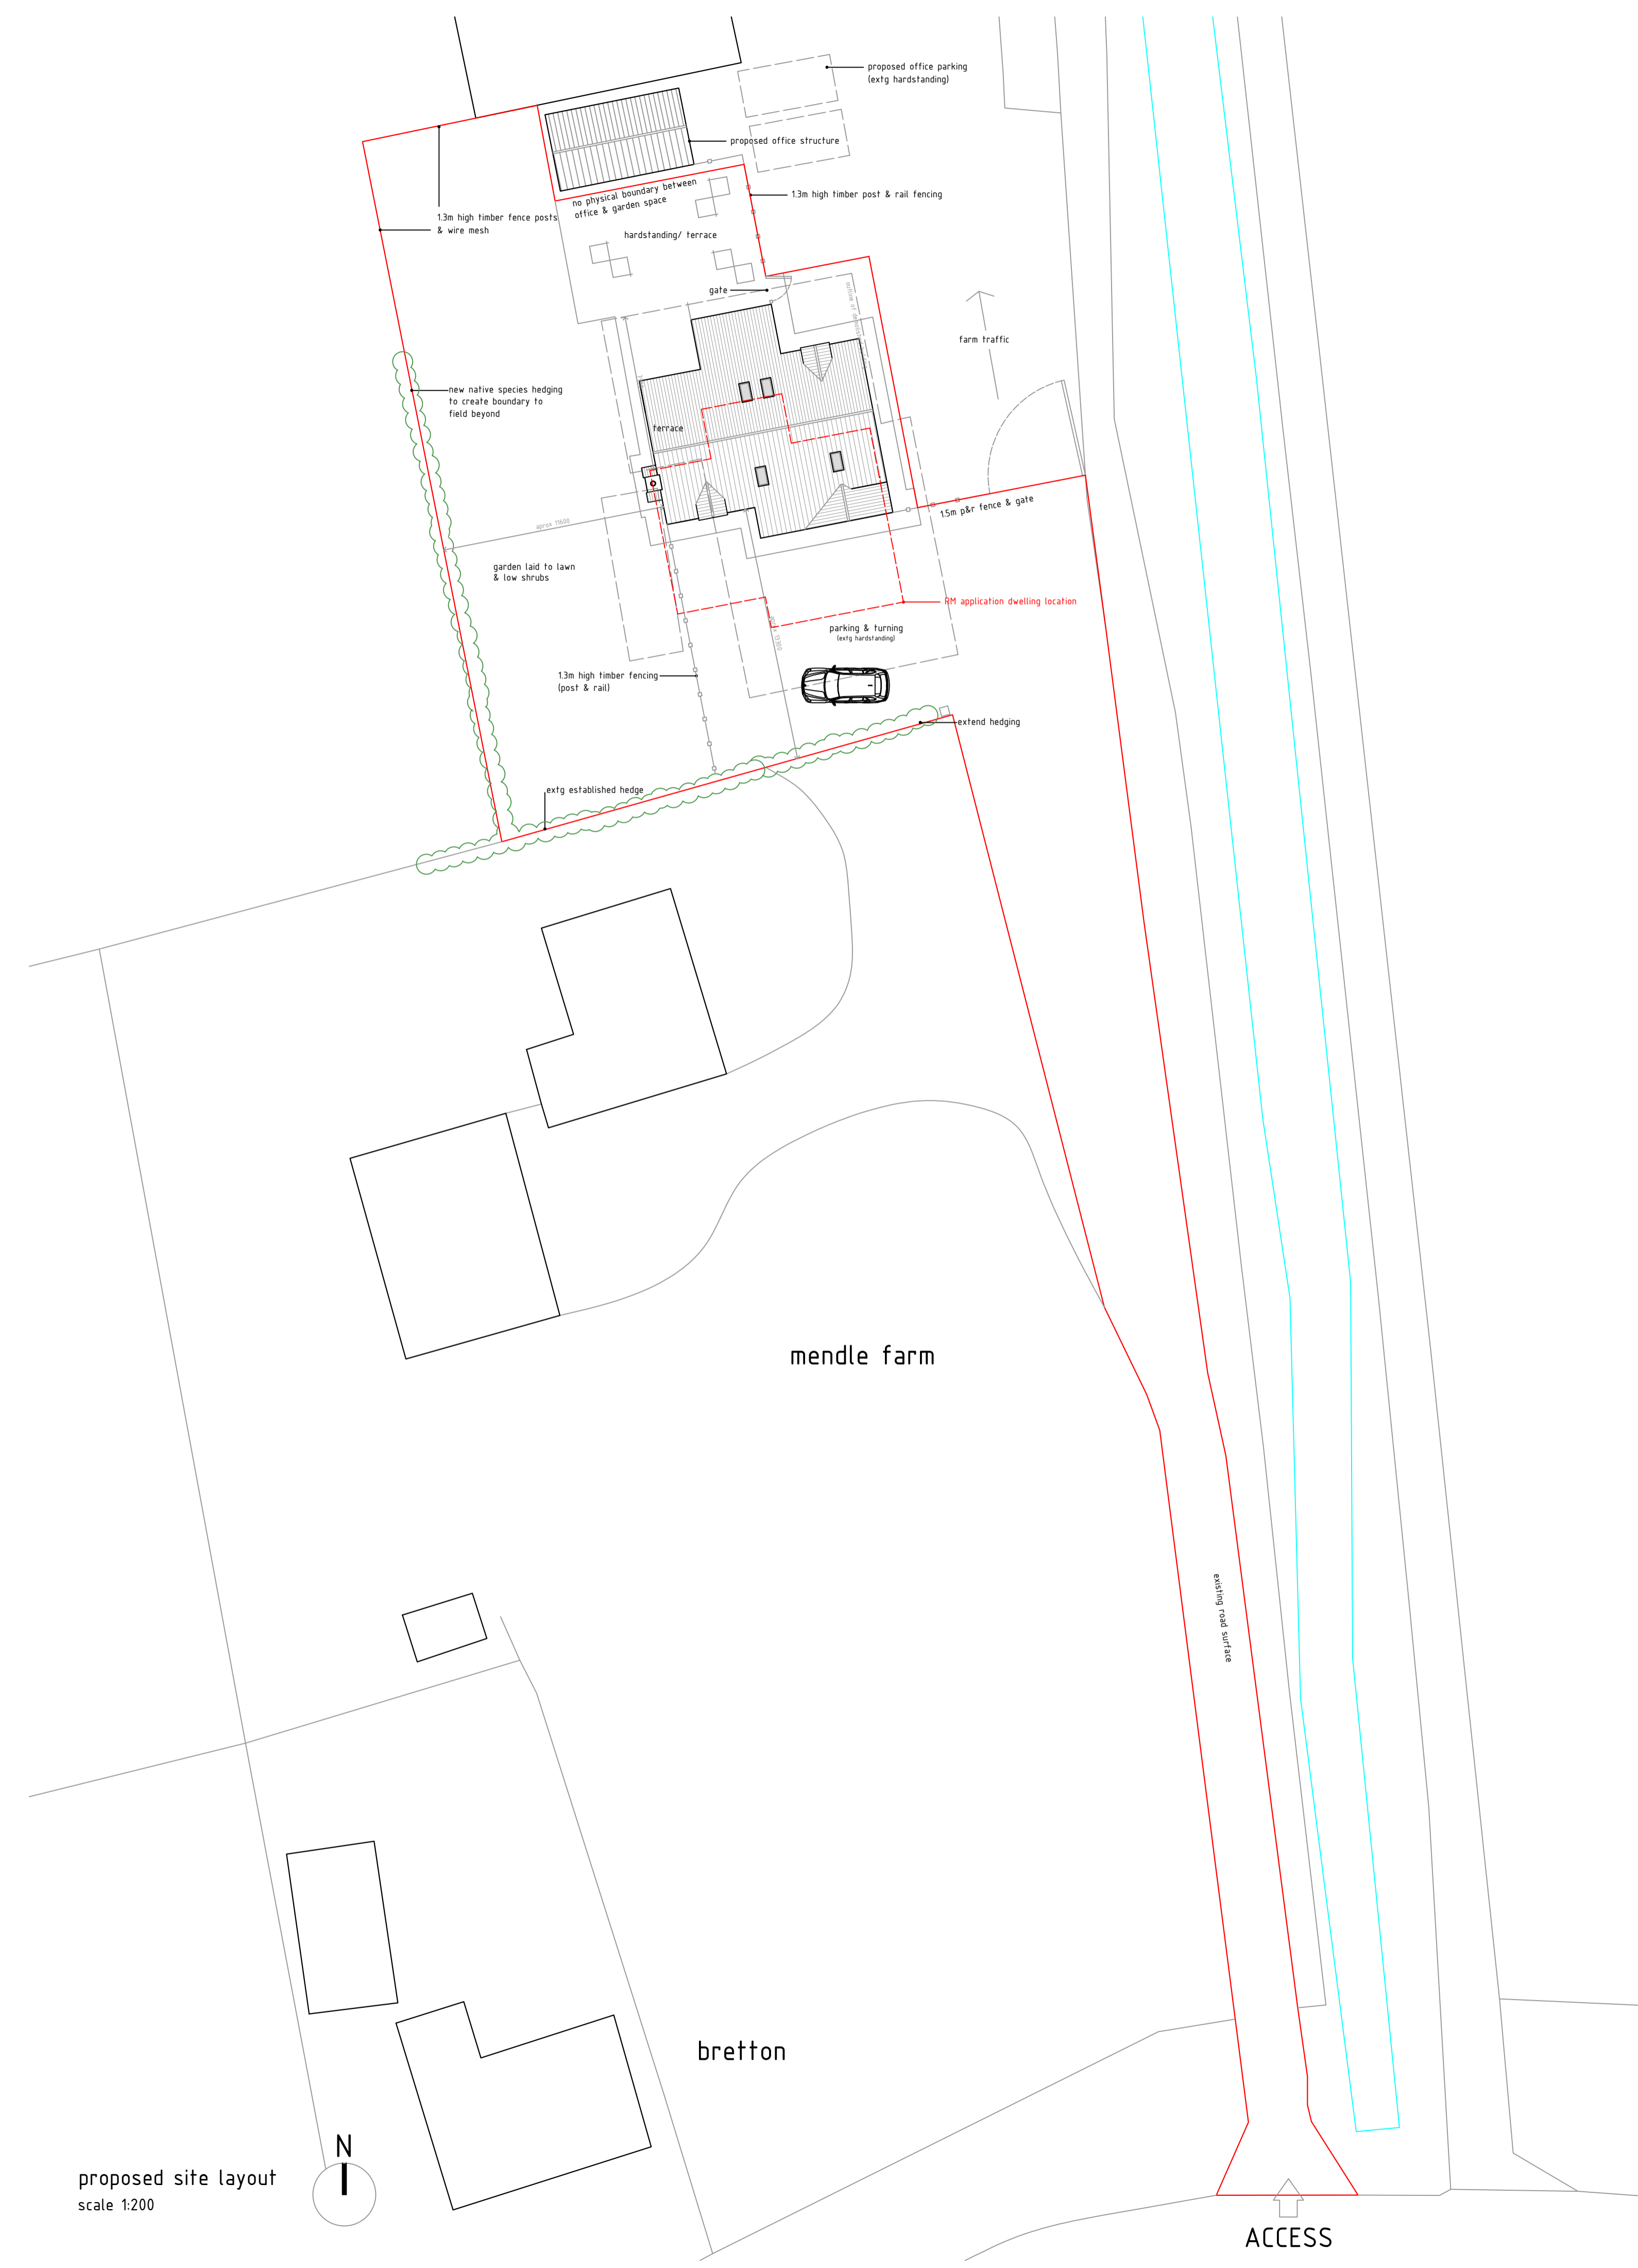

proposed site layout
scale 1:200



Retrospective Planning Application
Mendle Farm, Holme Lane, Holme, DN16 3RF
Client: Mr. J. Richardson

Issue Status	
Consultation	<input type="checkbox"/>
Planning	<input checked="" type="checkbox"/>
B Regs	<input type="checkbox"/>
Construction	<input type="checkbox"/>

Title:
- site location plan
- proposed site layout
- proposed block plan

Revision details:
rev a 03/06/2025
Site layout changed to reflect 'as built'.
Red line area changed

Drwg No: HO/RI/MF/02 rev a
Scale: as indicated @ A1
Date: 08/10/2019

