




As Built Rear Elevation A
1 : 100

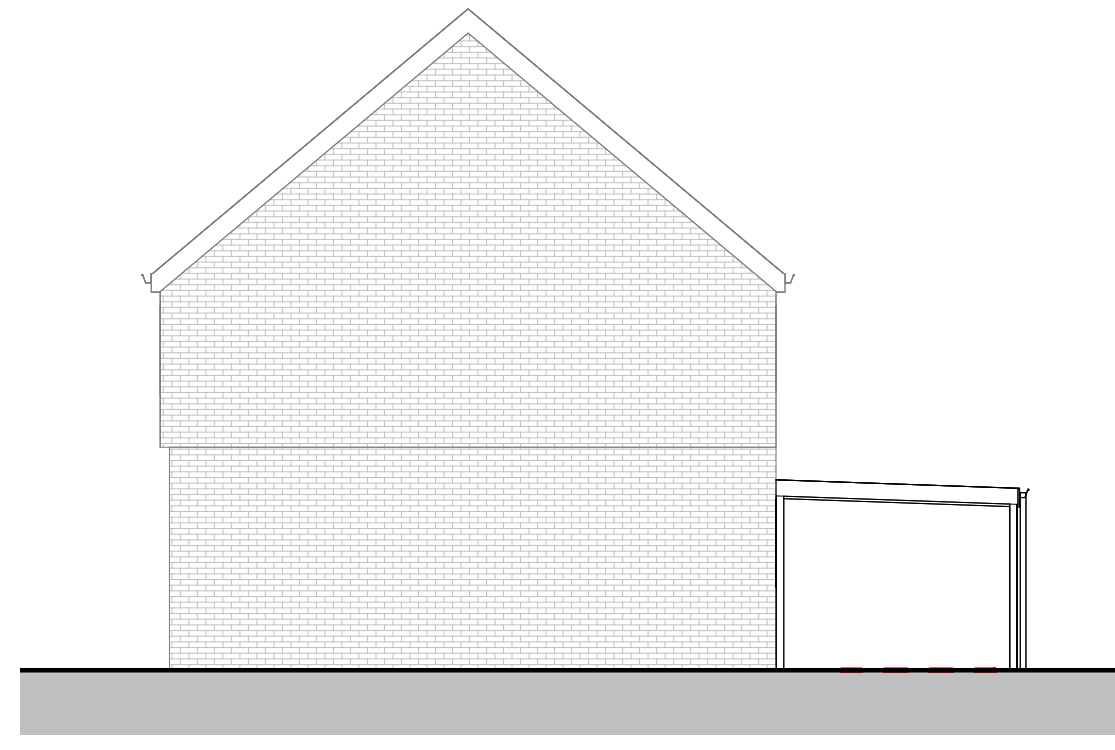

As Built Side Elevation B
1 : 100

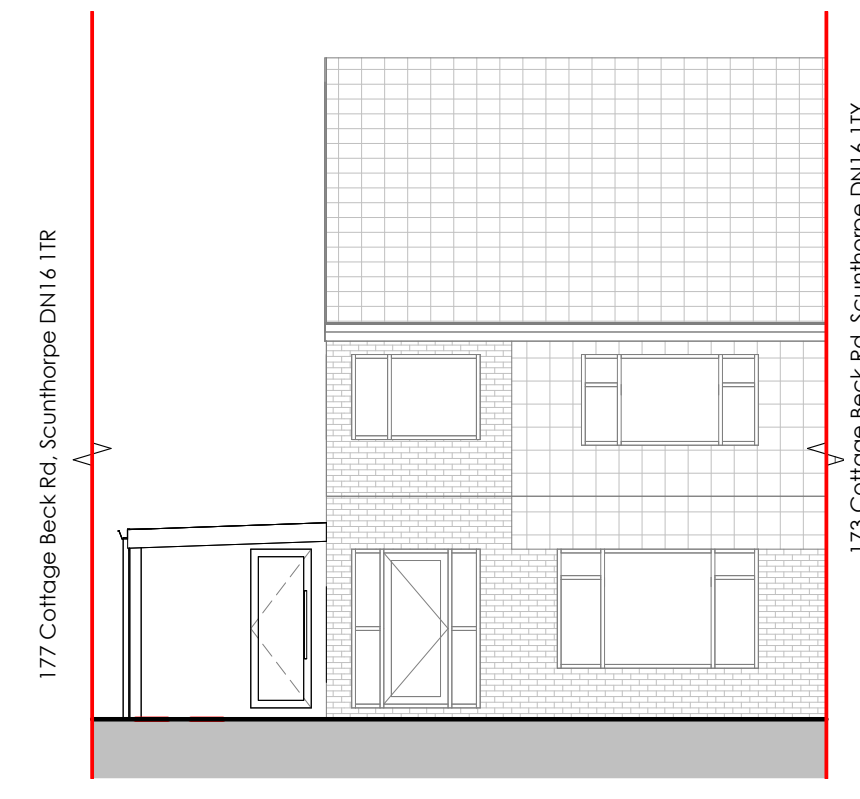

As Built Front Elevation C
1 : 100

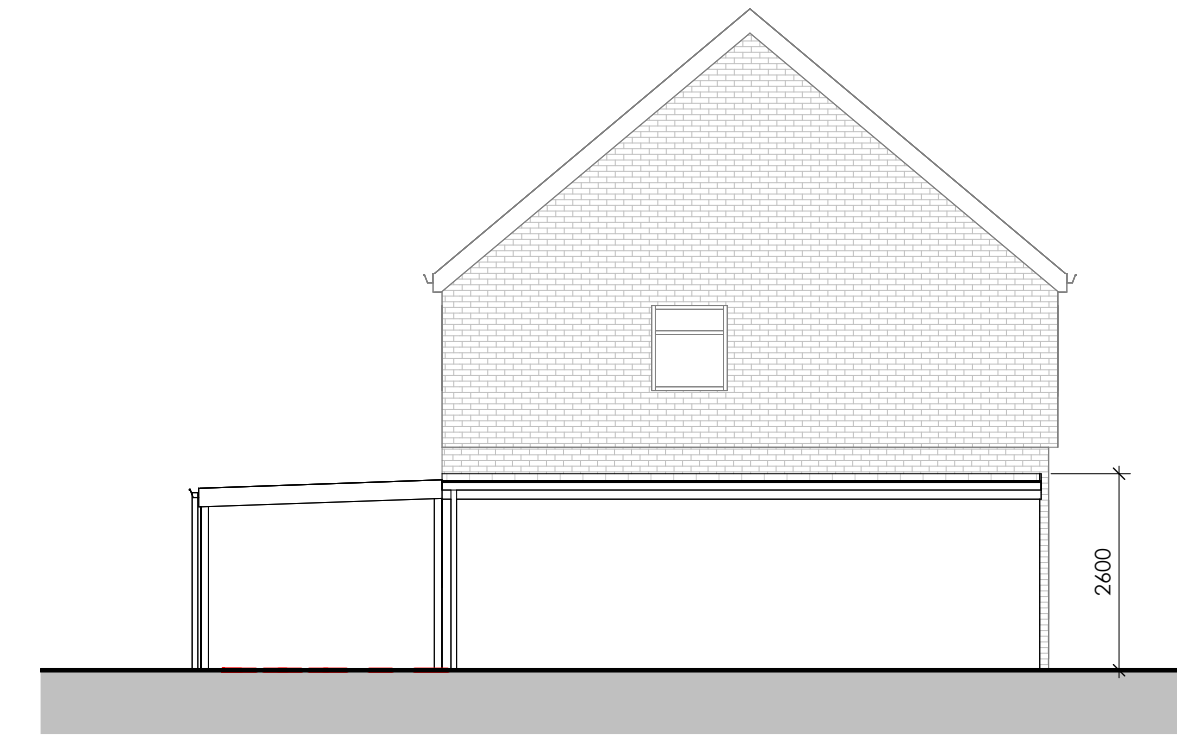


As Built Side Elevation D
1 : 100

This drawing to be read in conjunction with all specifications and all other consultants design information. Any contradictions between this drawing and any other design information to be advised to the contract administrator and author immediately.

The contractor to site measure, check and verify all information issued, and confirm the correctness of the contents prior to the commencement on site.

The contractor to comply with all current statutory legislation, Building Regulations, British Standards, and good building practice. Do not scale from this drawing.


Revision		Date	Init	
rev	description	date	dr by	ap by

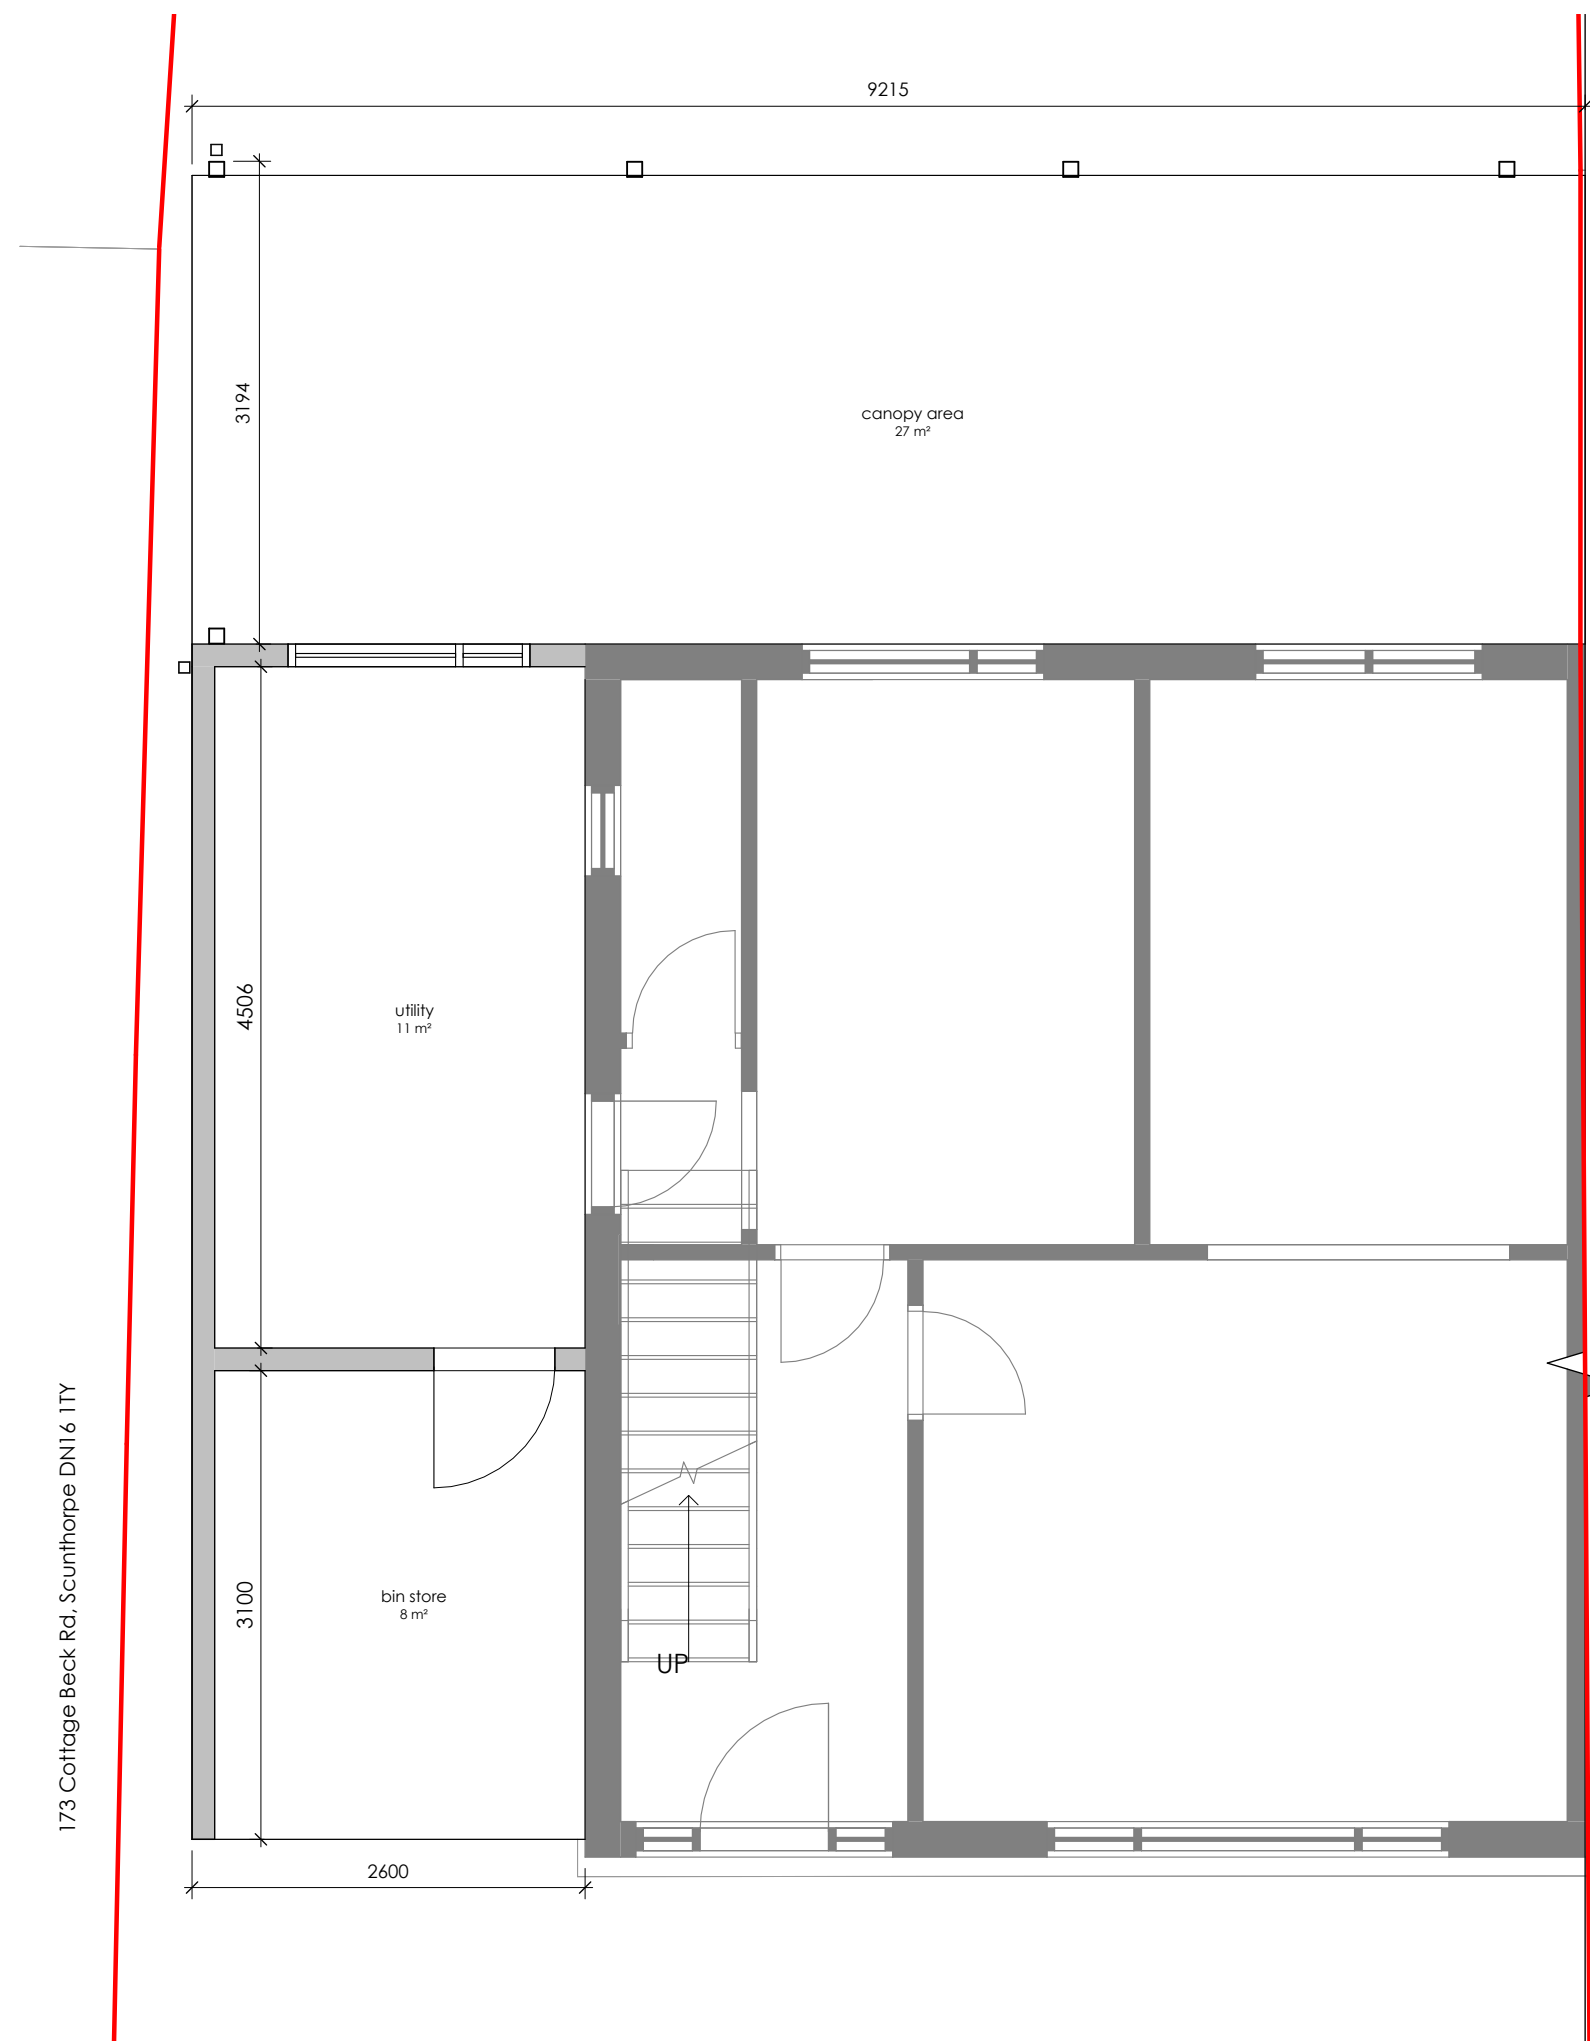


As Built GF Plan
1 : 50



As Built FF Plan
1 : 50

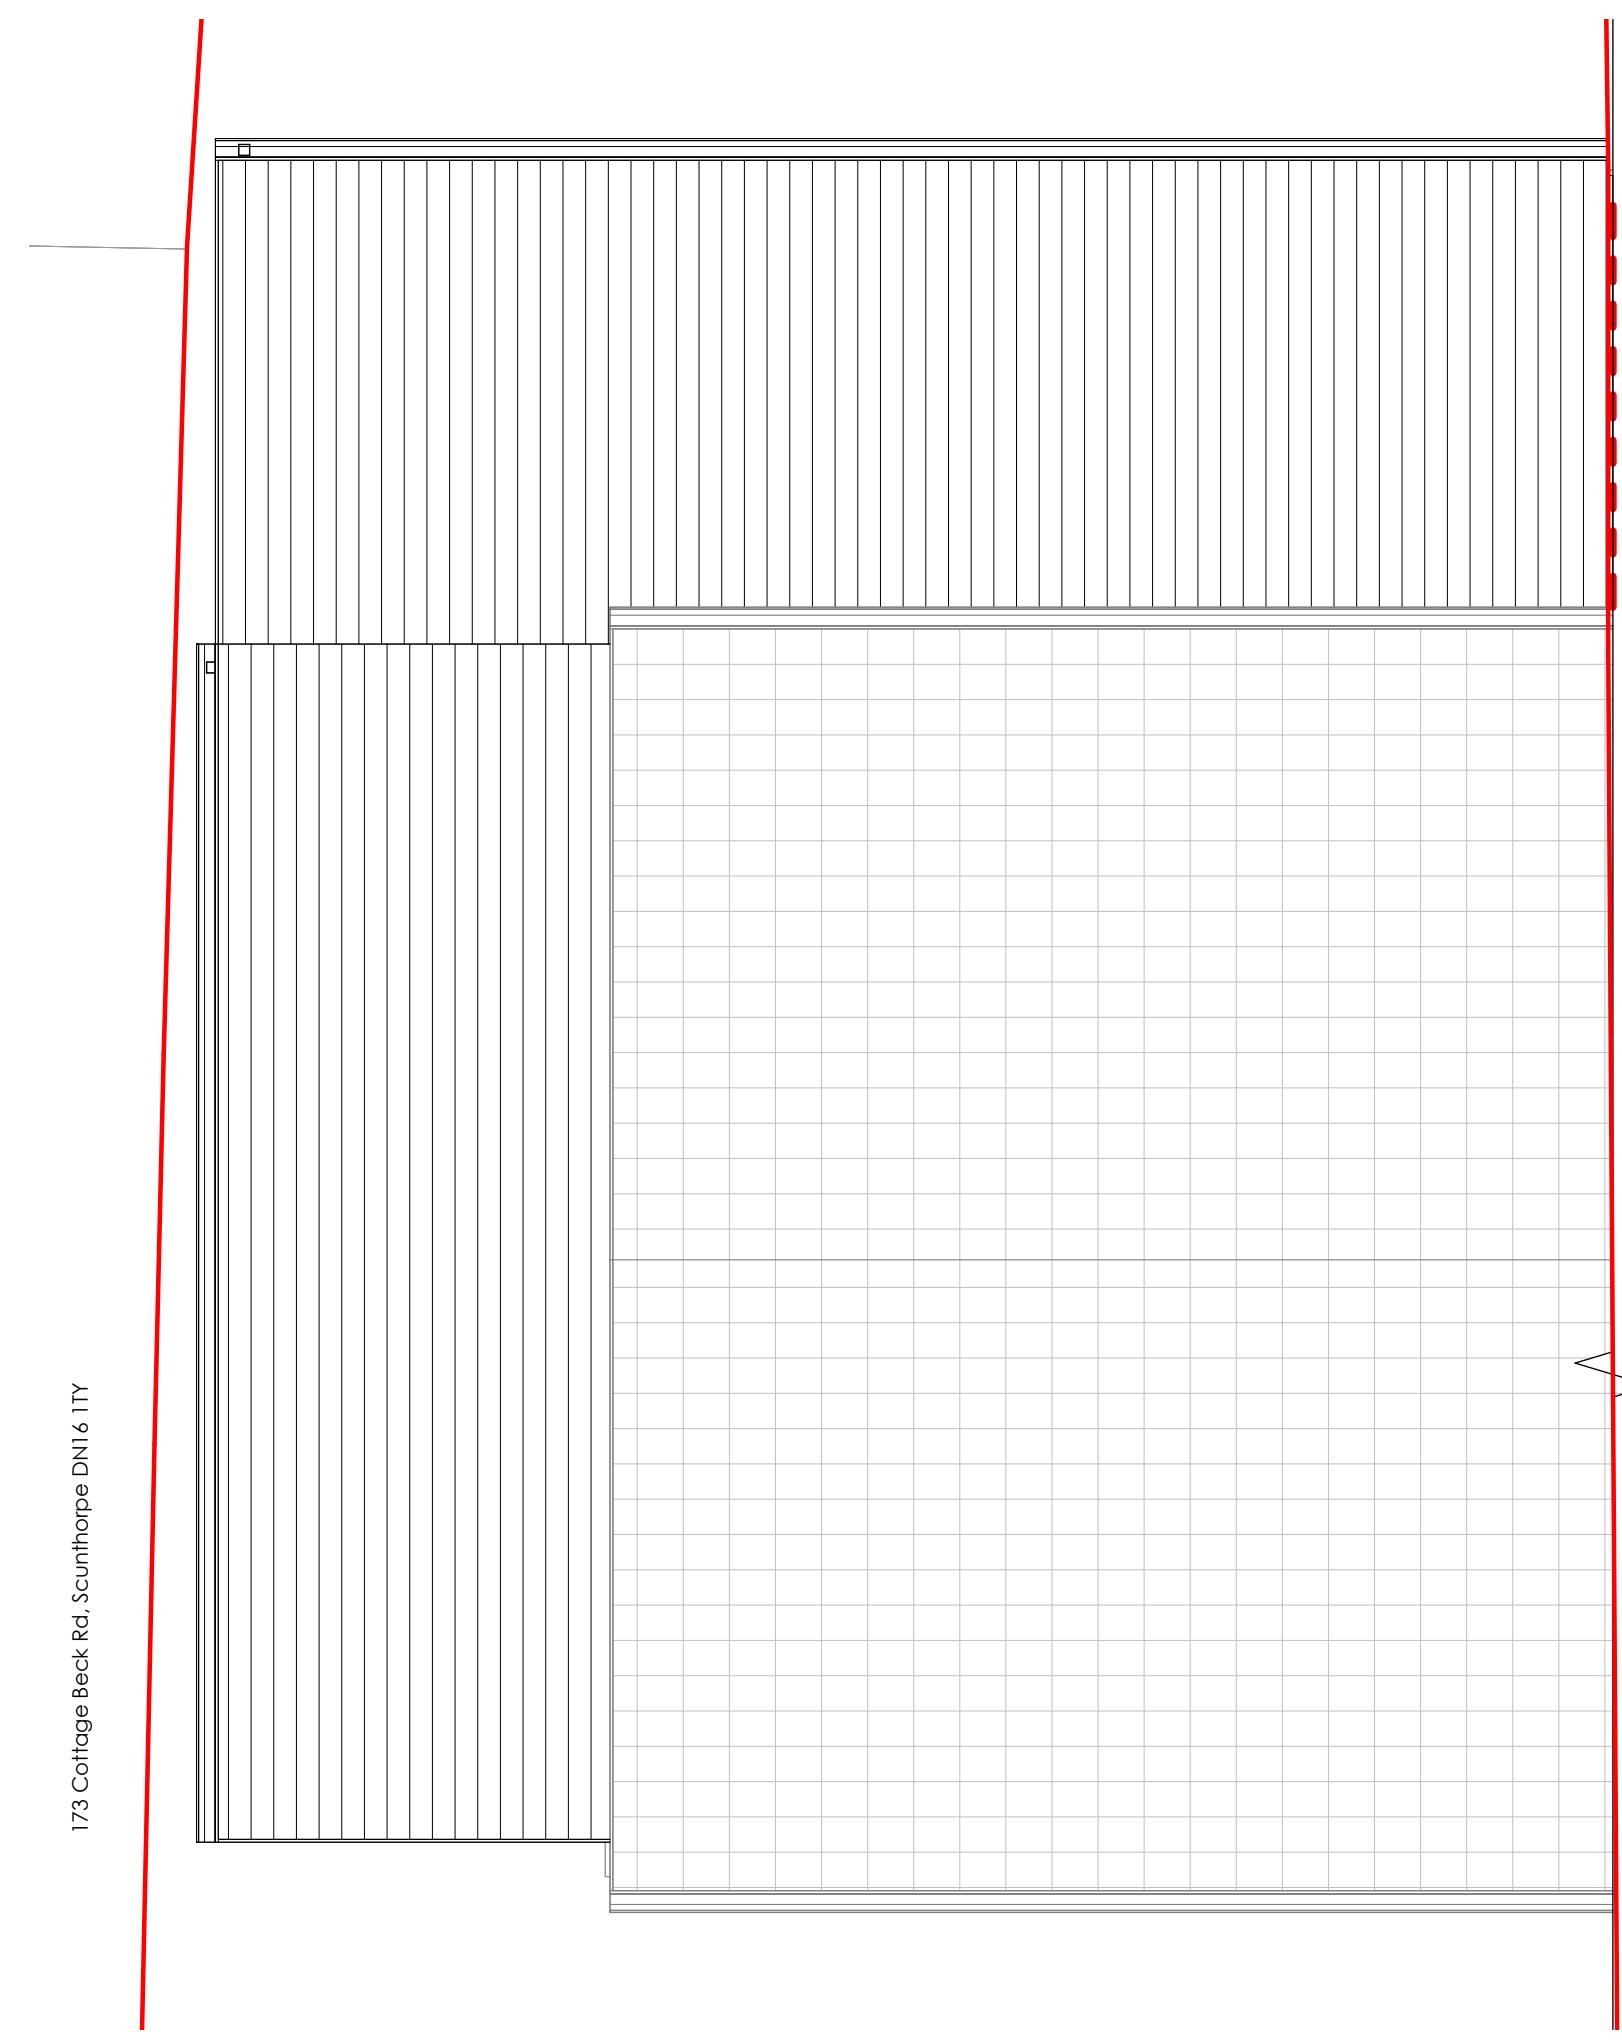

As Built Roof Plan
1 : 50

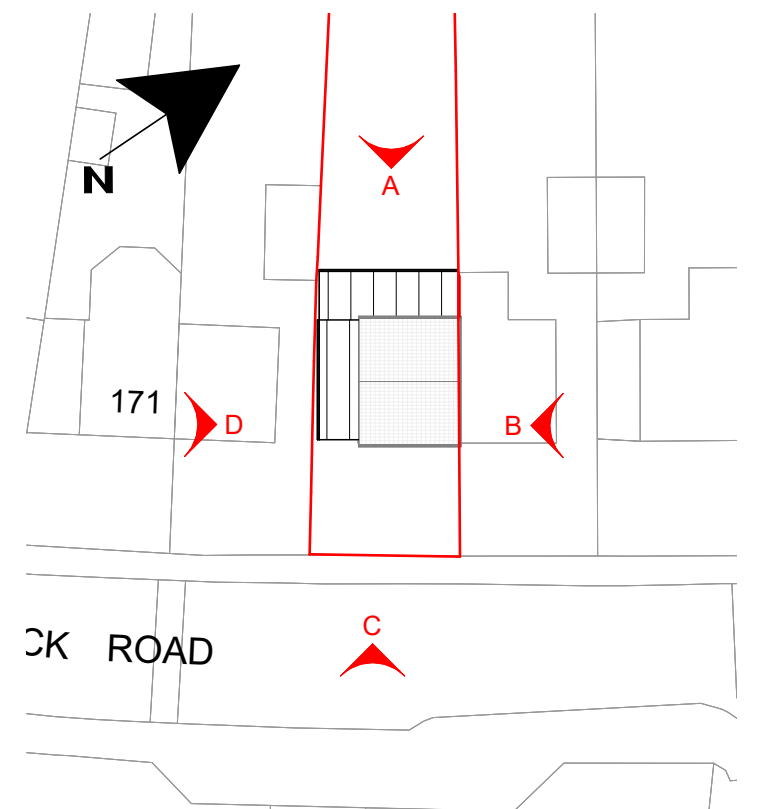

Key Plan
1 : 500

client: Mr Kazan Mohammed		
project address: 175 Cottage Beck Rd, Scunthorpe DN16 1TR		
project: Retrospective Application for side extension and rear canopy		
title: As Built Plans Elevations		
date: 23.07.25	scale: As indicated @ A1	status: retrospective
drawn by: SM	dwg ref: SM-XX-00-DR-A-102	rev:
checked by: GAG		
<small>© the drawing, design and the building works depicted are the copyright of SM10 Studio & may not be reproduced or amended, except by the written permission of SM10 Studio. No liability will be accepted for any omissions made by other persons.</small>		
<small>The issue of this drawing/document does not confer any license for use of the design to any party whatsoever save as expressly agreed by SM10 Studio.</small>		

SM10 STUDIO ARCHITECTURE

SM10 Studio Architecture
2 West Chantry
Harrow, HA3 6HX

phone : 074233 23372
e-mail : info@sm10studio.co.uk

