




This drawing to be read in conjunction with all specifications and all other consultants design information. Any contradictions between this drawing and any other design information to be advised to the contract administrator and author immediately.

The contractor to site measure, check and verify all information issued, and confirm the correctness of the contents prior to the commencement on site.

The contractor to comply with all current statutory legislation, Building Regulations, British Standards, and good building practice. Do not scale from this drawing.

Revision		Date		Init
rev	description	date	dr by	ap by

ReQuestAPlan
 Map number: TQRQM25204140007649
 File: 25525204 - 175 Cottage Beck Rd, Scunthorpe DN16 1BB
 Map Produced for: Mr. Kazan Mohammed
 © Crown copyright and database rights 2025 OS 100042796
 Project ID:
 Date of Purchase: 23/07/2025
 1 Year subscription from 23/07/2025 for 1 workstation.

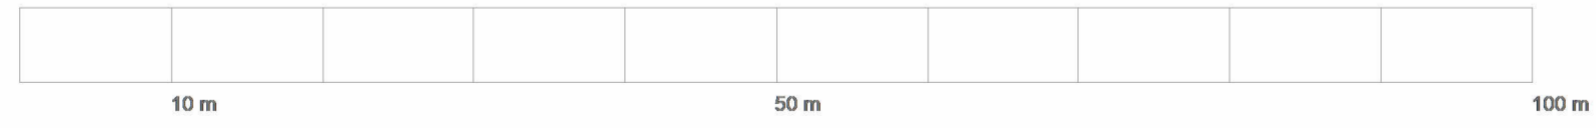

As Built Sun Analysis
 1 : 500



client: Mr Kazan Mohammed		
project: Retrospective Application for side extension and rear canopy		
title: Sunlight Analysis As Built		
date: 23.07.25	scale: As indicated	status: retrospective
drawn by: SM	dwg ref: SM-XX-S-DR-A-004	rev :
checked by: OAG		
<small>© the drawing, design and the building works depicted are the copyright of SM10 Studio & may not be reproduced or amended, except by the written permission by SM10 Studio. No liability will be accepted for any amendments made by other persons.</small> <small>The issue of this drawing/document does not confer any license for use of the design to any party whatsoever save as expressly agreed by SM10 Studio.</small>		

SM10 STUDIO ARCHITECTURE

SM10 Studio Architecture
 41 Ryecroft
 Lincoln, LN5 9UL

Mob: 0747 262 3056
 shahin.mohammed@sm10studio.co.uk