




proposed side (east) elevation
Scale 1:50



proposed rear (north) elevation
Scale 1:50

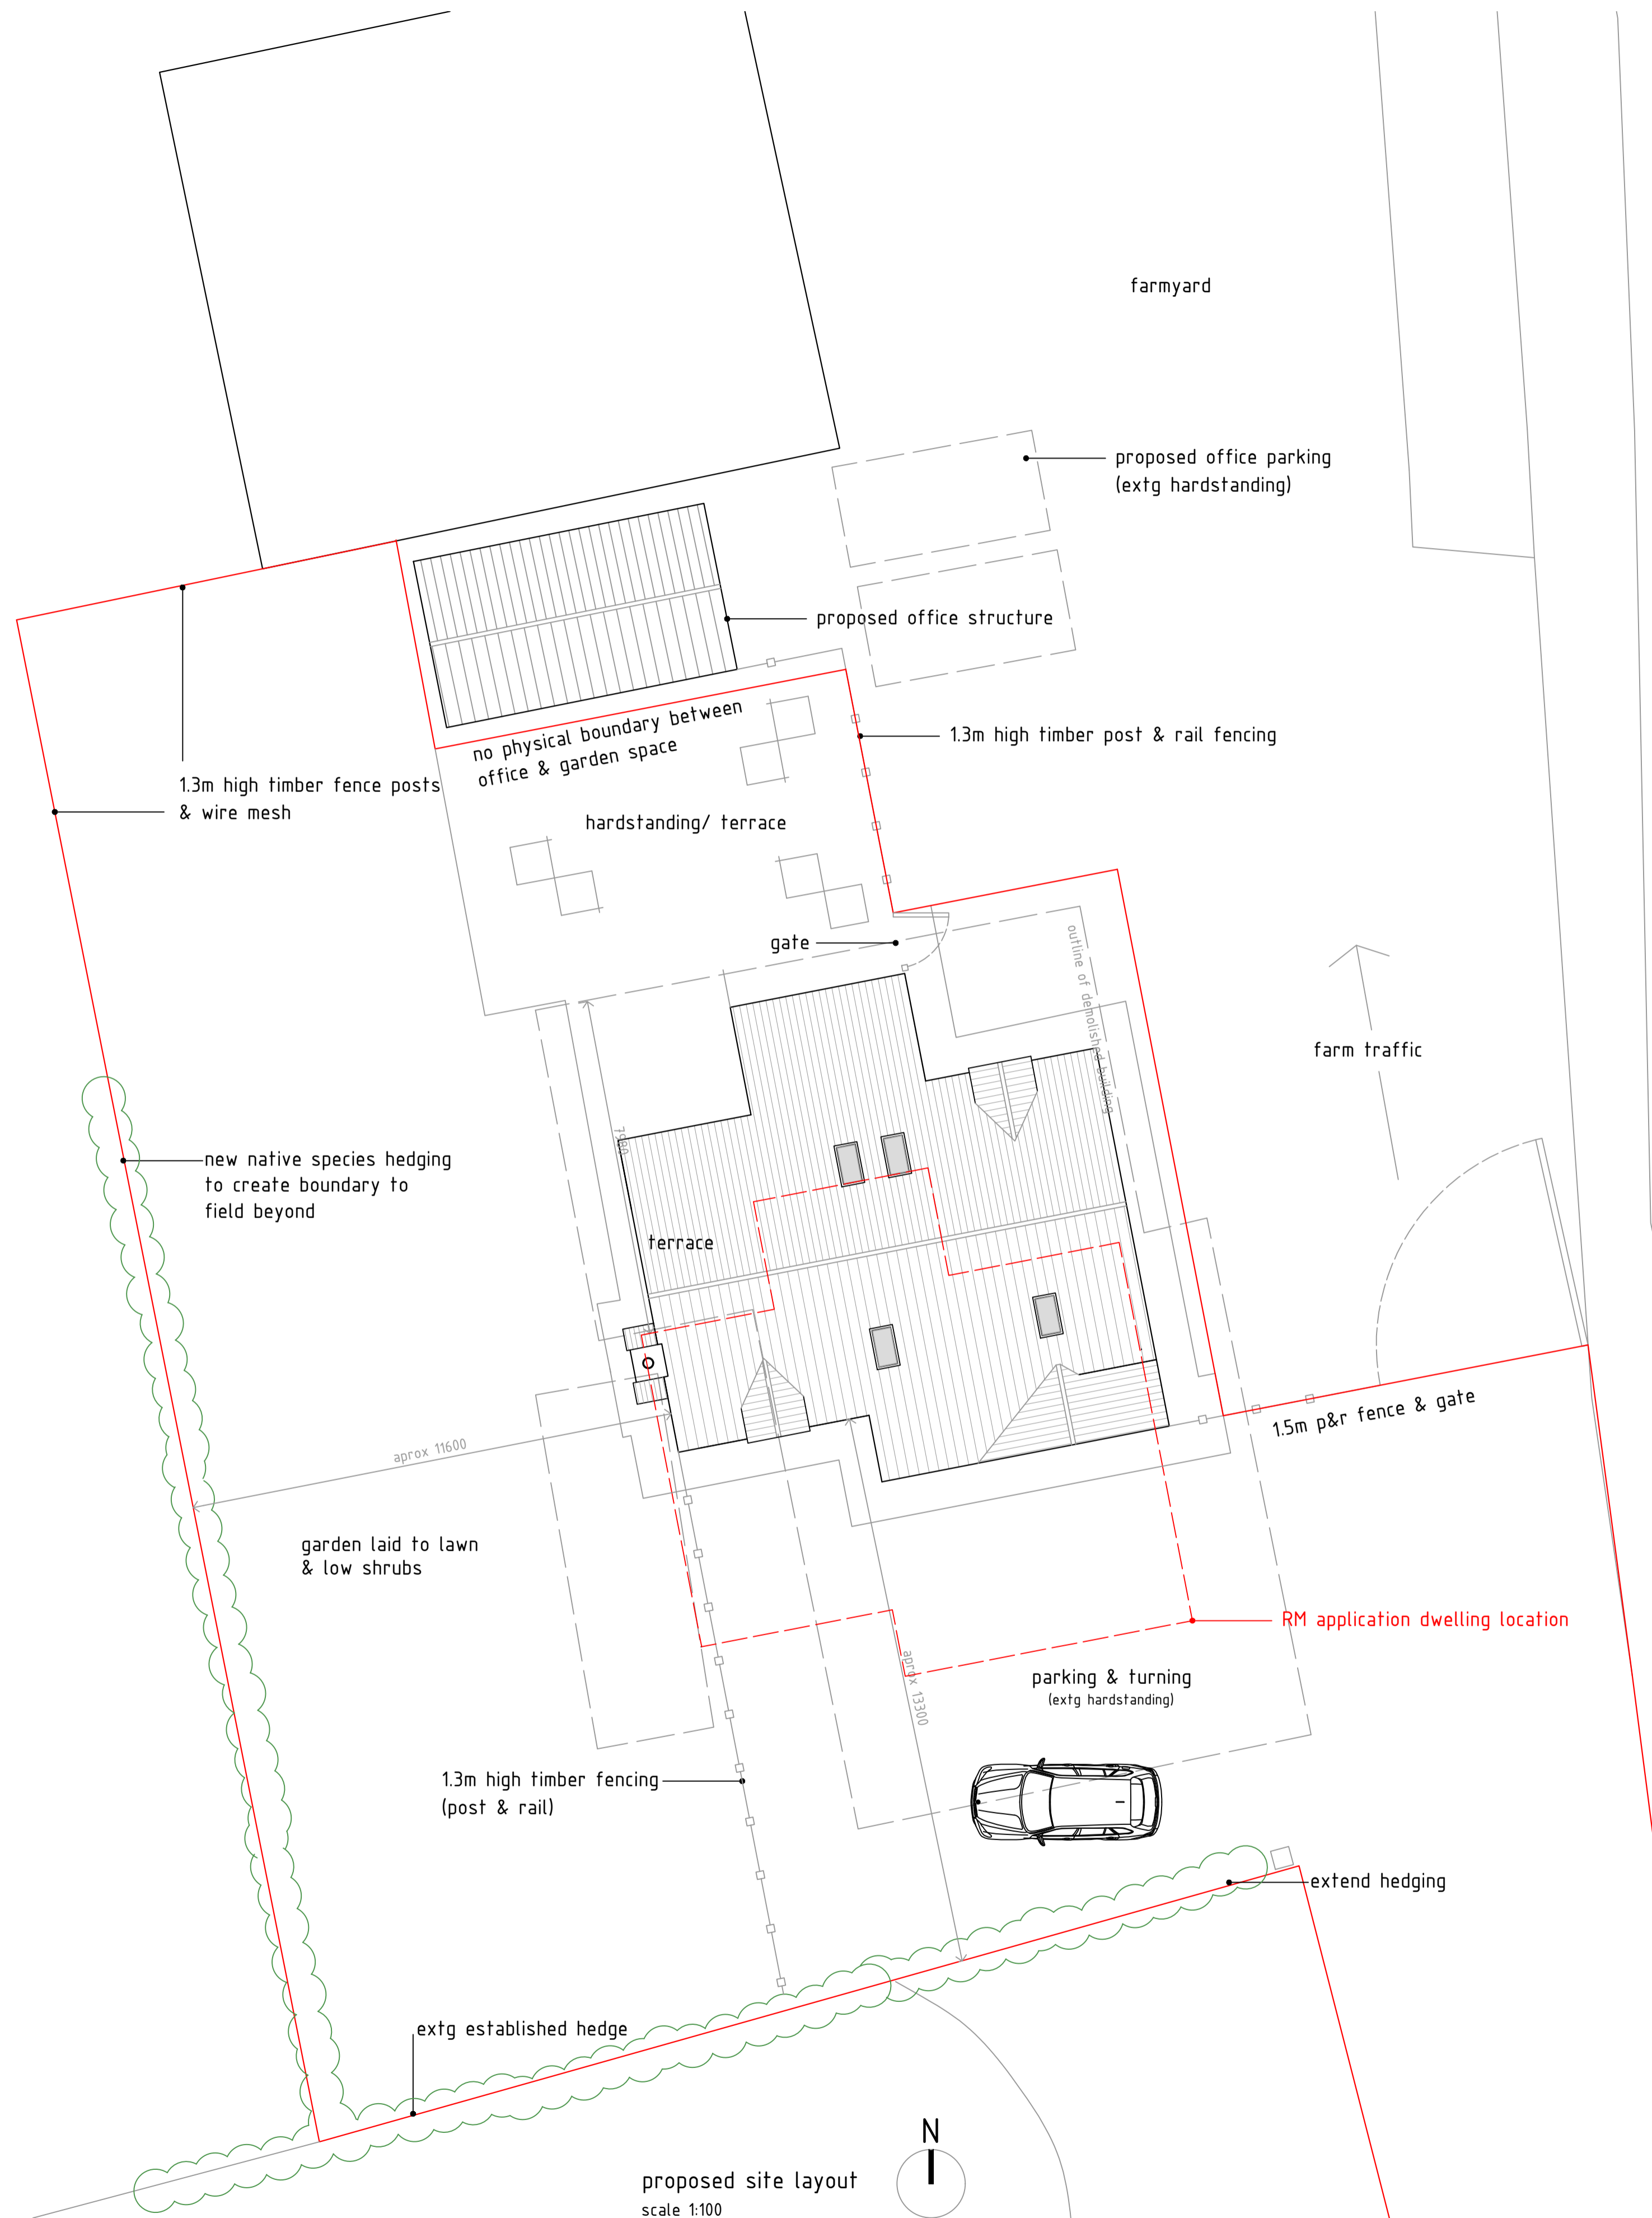

proposed site layout
scale 1:100



Retrospective Planning Application
Mendle Farm, Holme Lane, Holme, DN16 3RF

Client: Mr. J. Richardson

Issue Status	
Consultation	<input type="checkbox"/>
Planning	<input checked="" type="checkbox"/>
B Regs	<input type="checkbox"/>
Construction	<input type="checkbox"/>

Title:
proposed dwelling
- proposed elevations
- proposed site layout
/ roof plan

Revision details:
rev a 03/06/2025
Site layout changed to reflect
"as built".

Drwg No: HO/RI/MF/03 rev a
Scale: as indicated @ A1
Date: 08/10/2019