




C Roundabout - CL - N Arm - Ch.0.00m

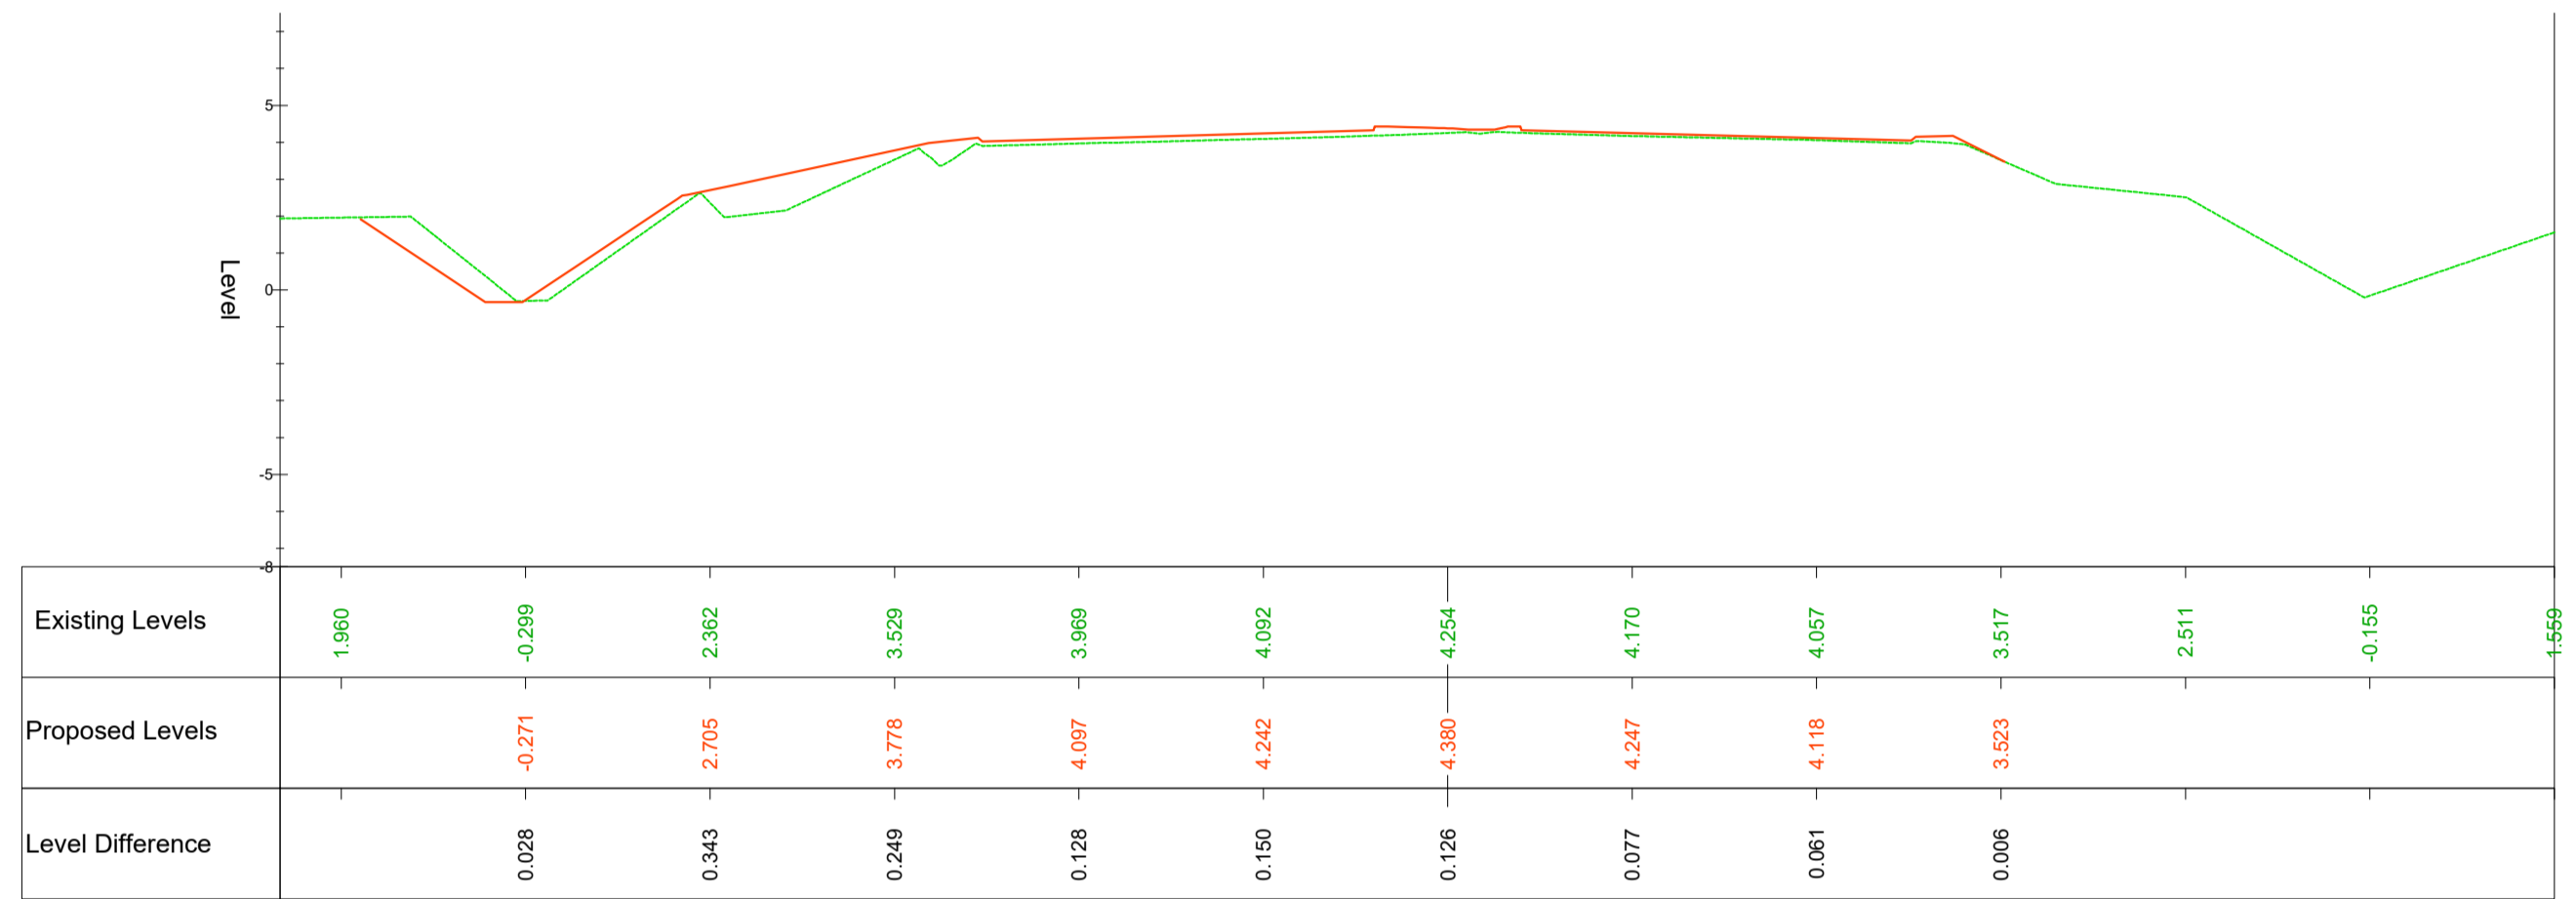


C Roundabout - CL - N Arm - Ch.20.00m

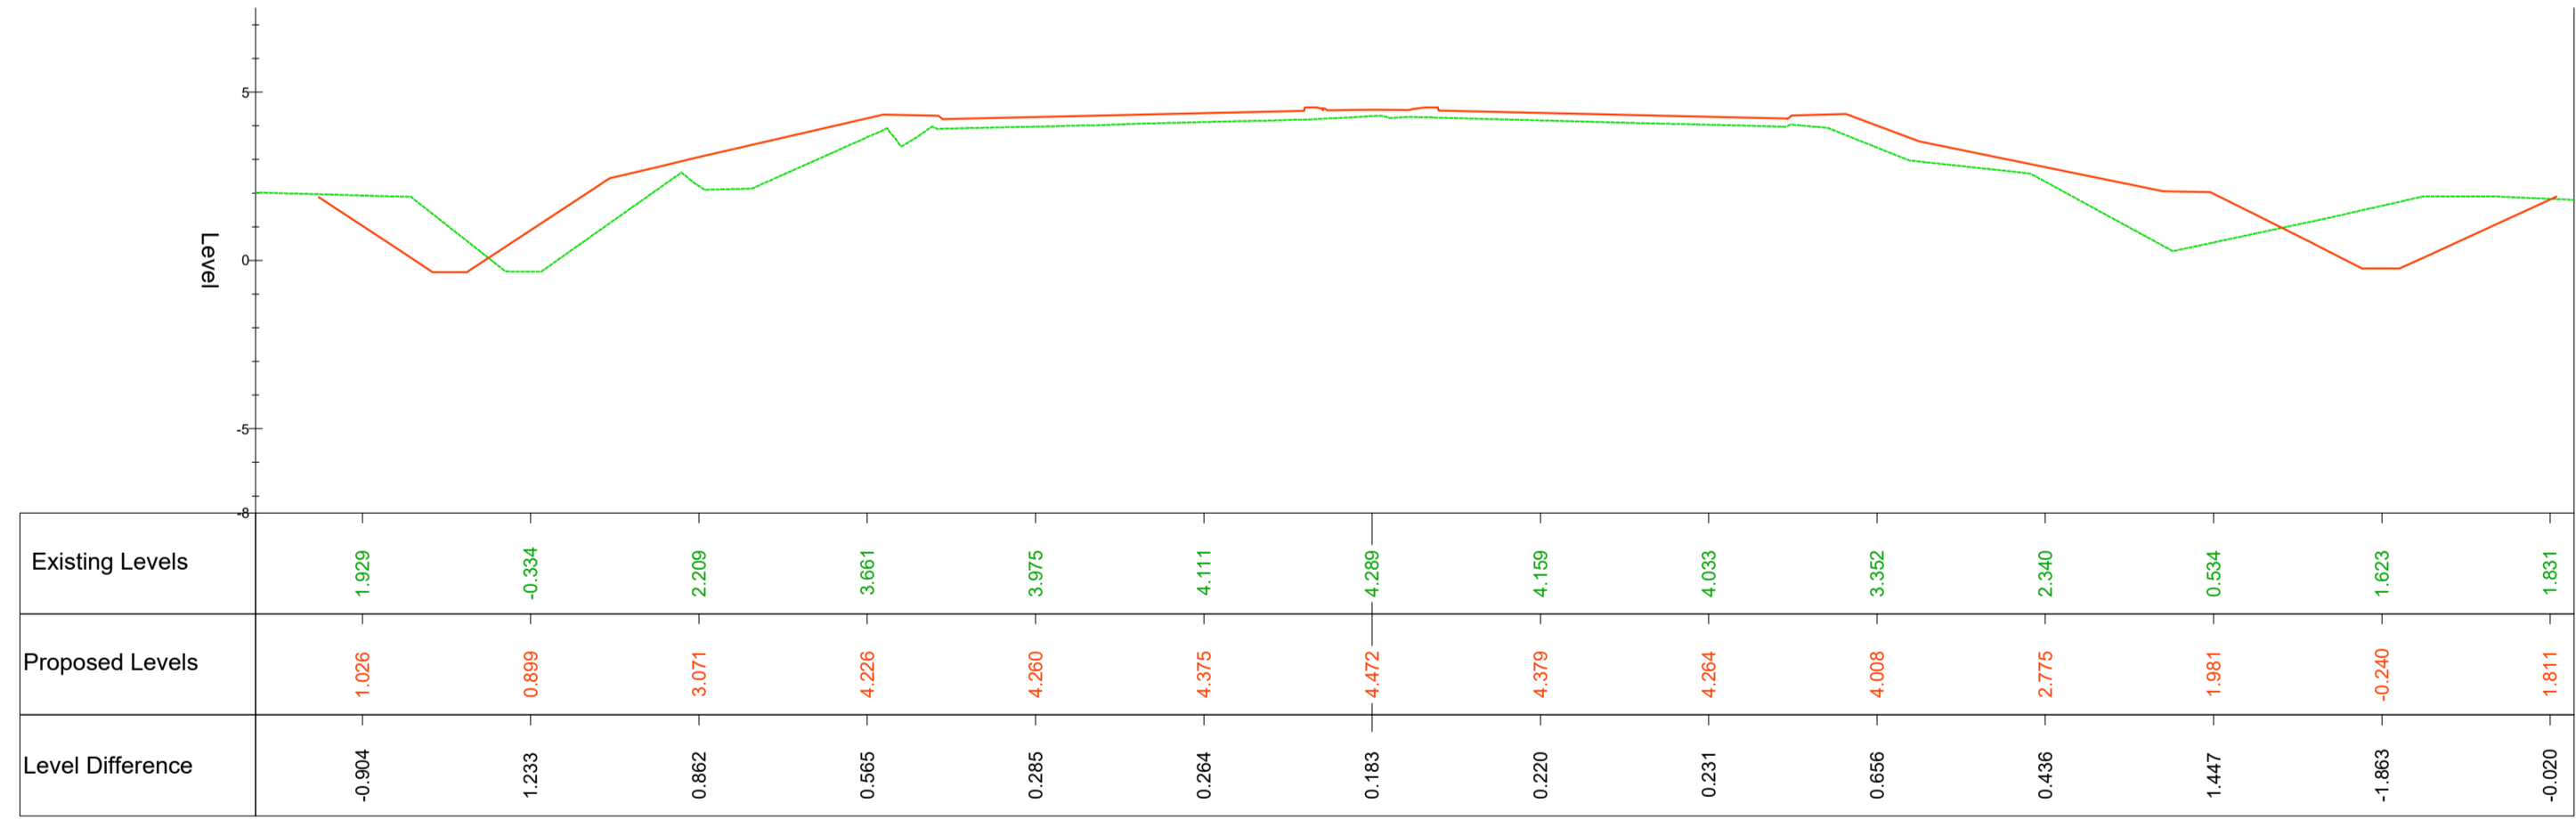


C Roundabout - CL - N Arm - Ch.40.00m

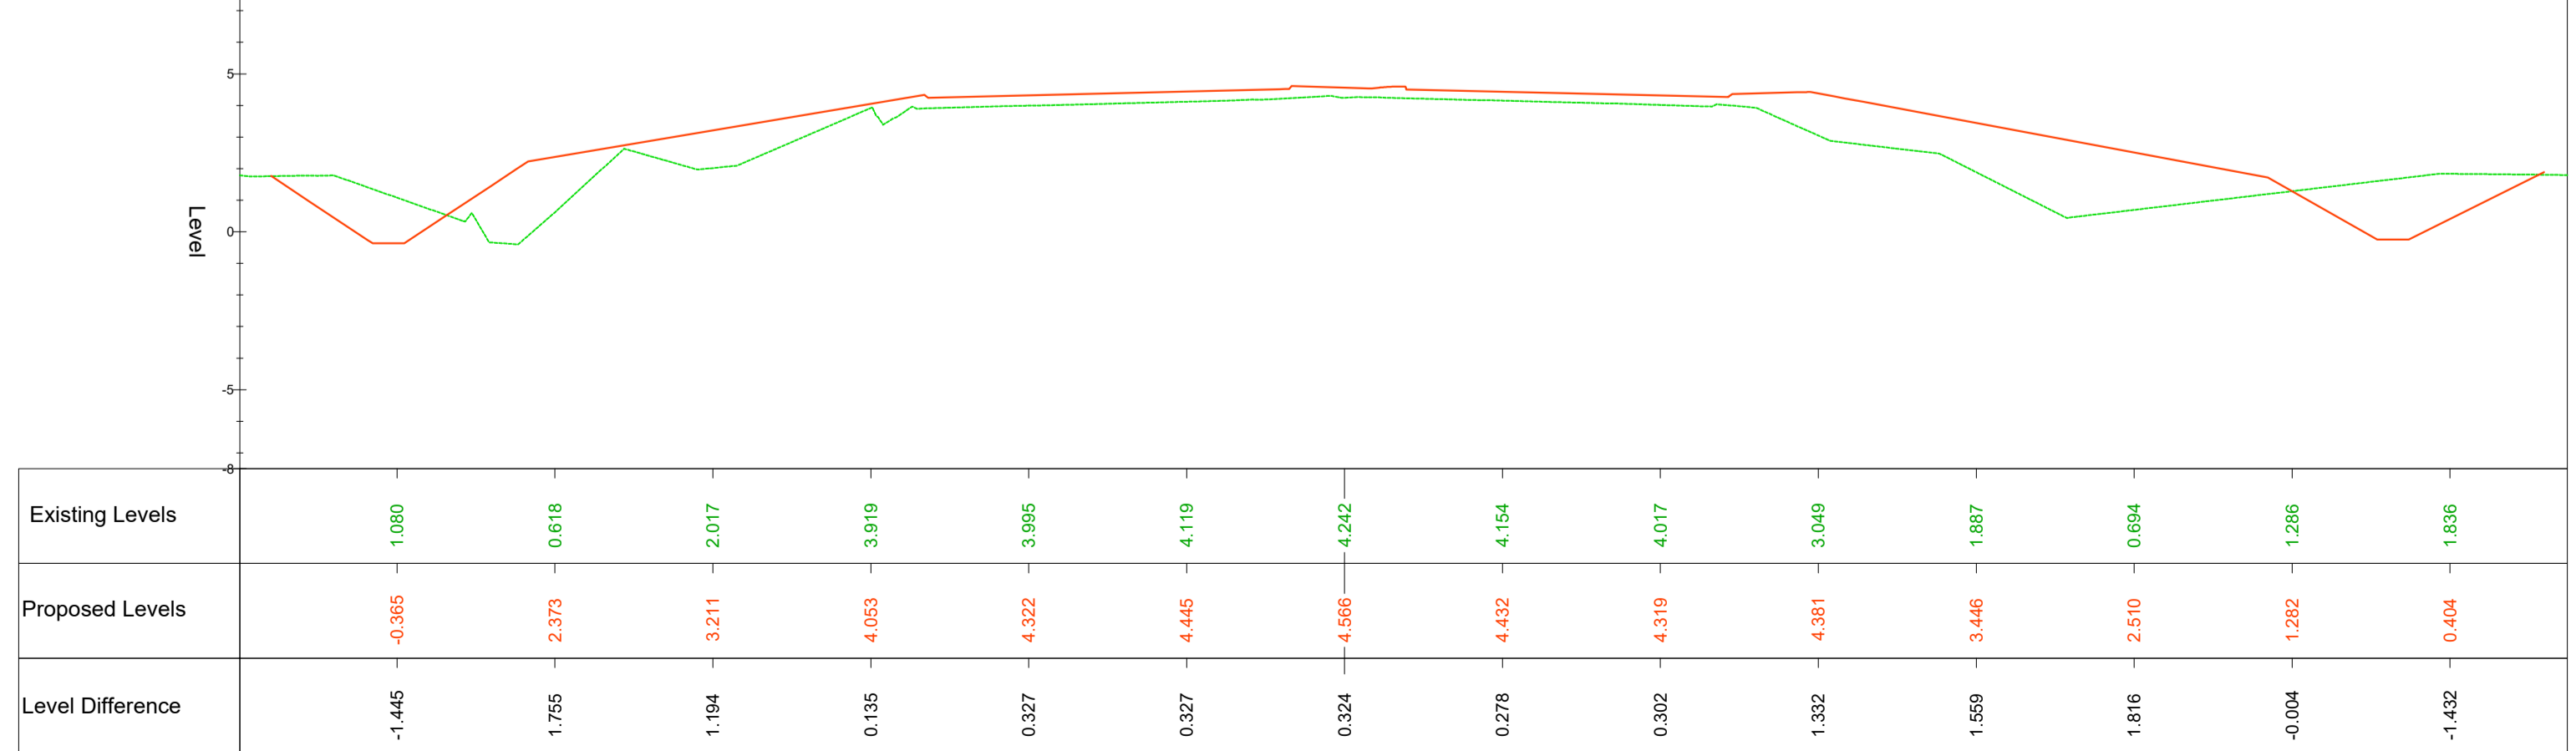

C Roundabout - CL - N Arm - Ch.60.00m

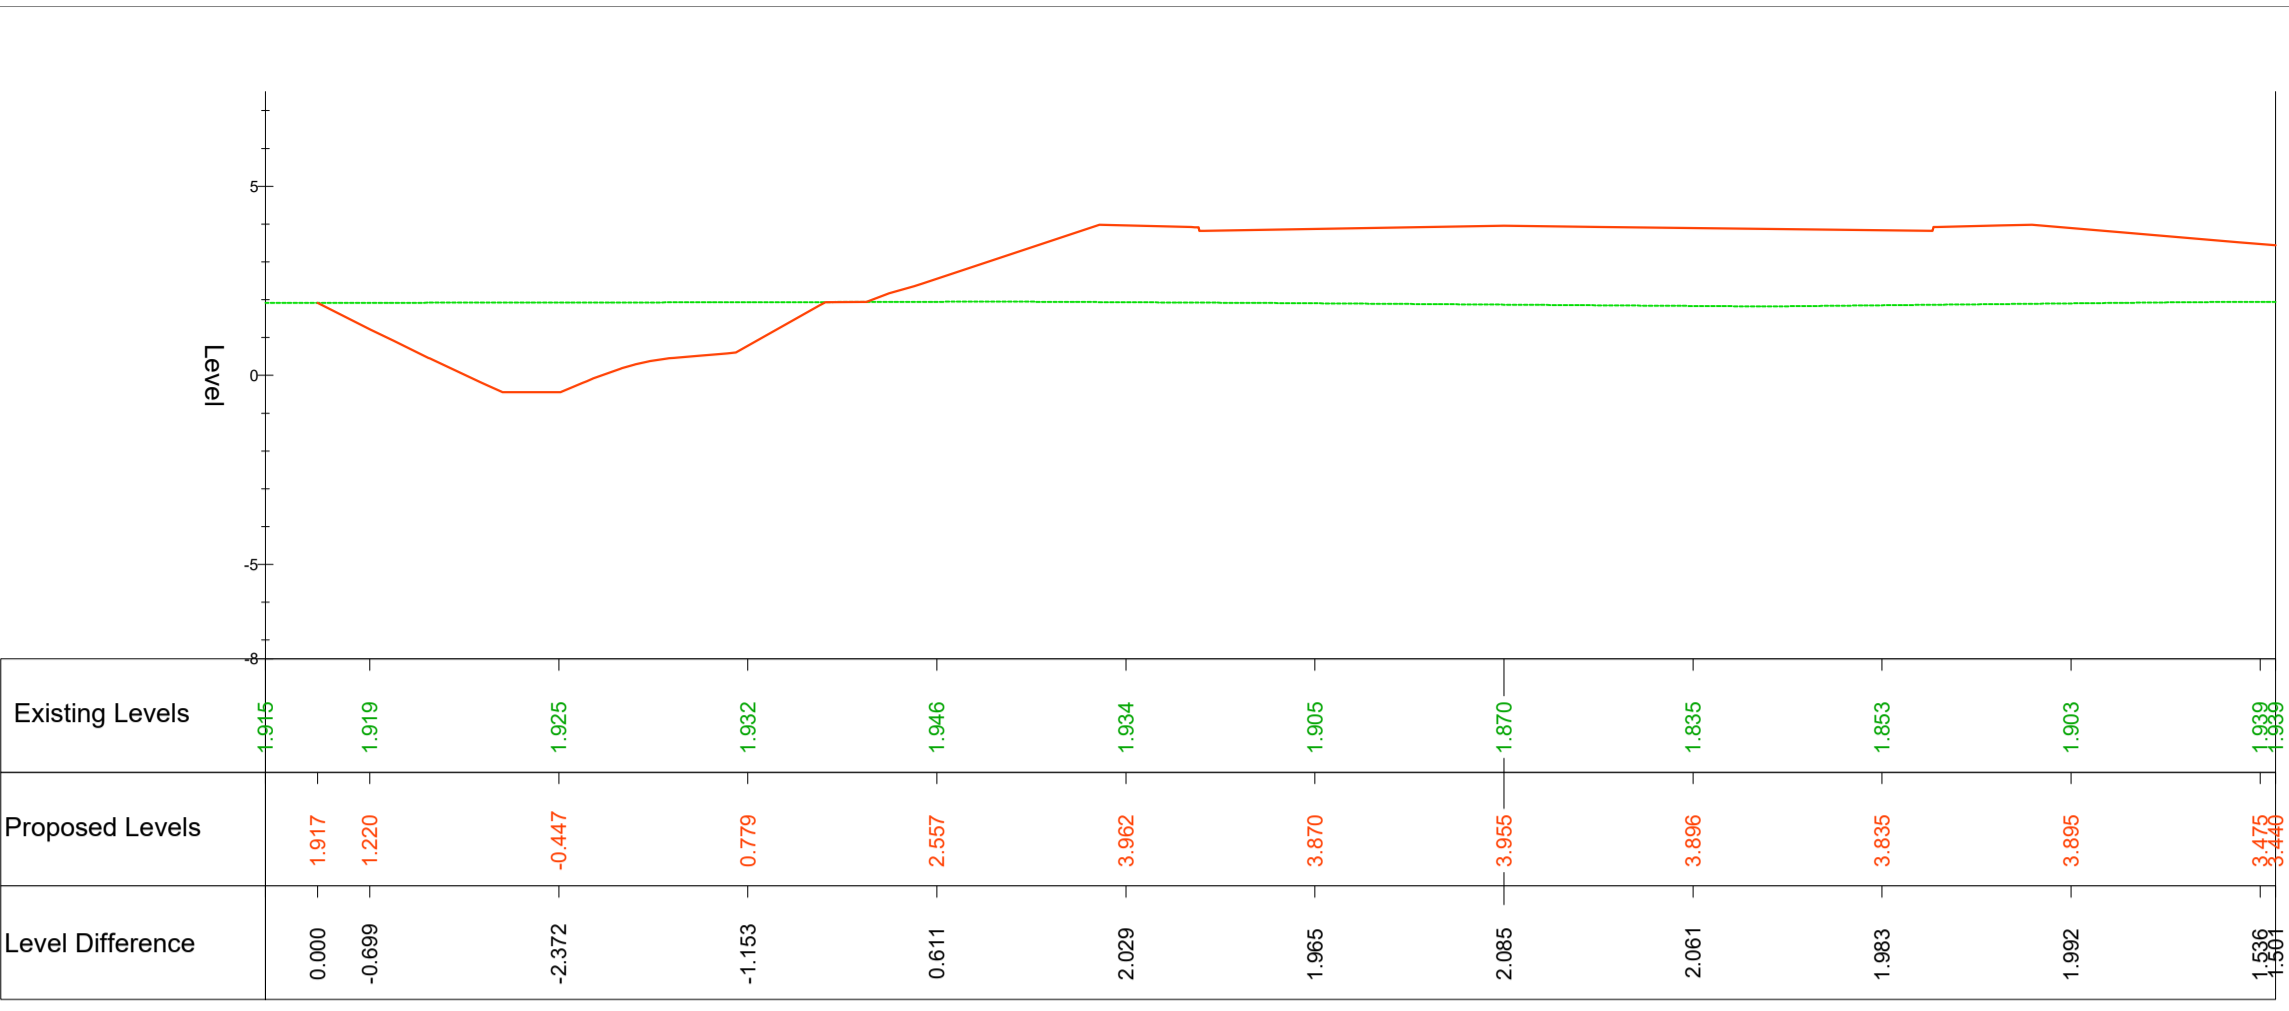

E Roundabout - CL - W Arm - Ch.20.00m

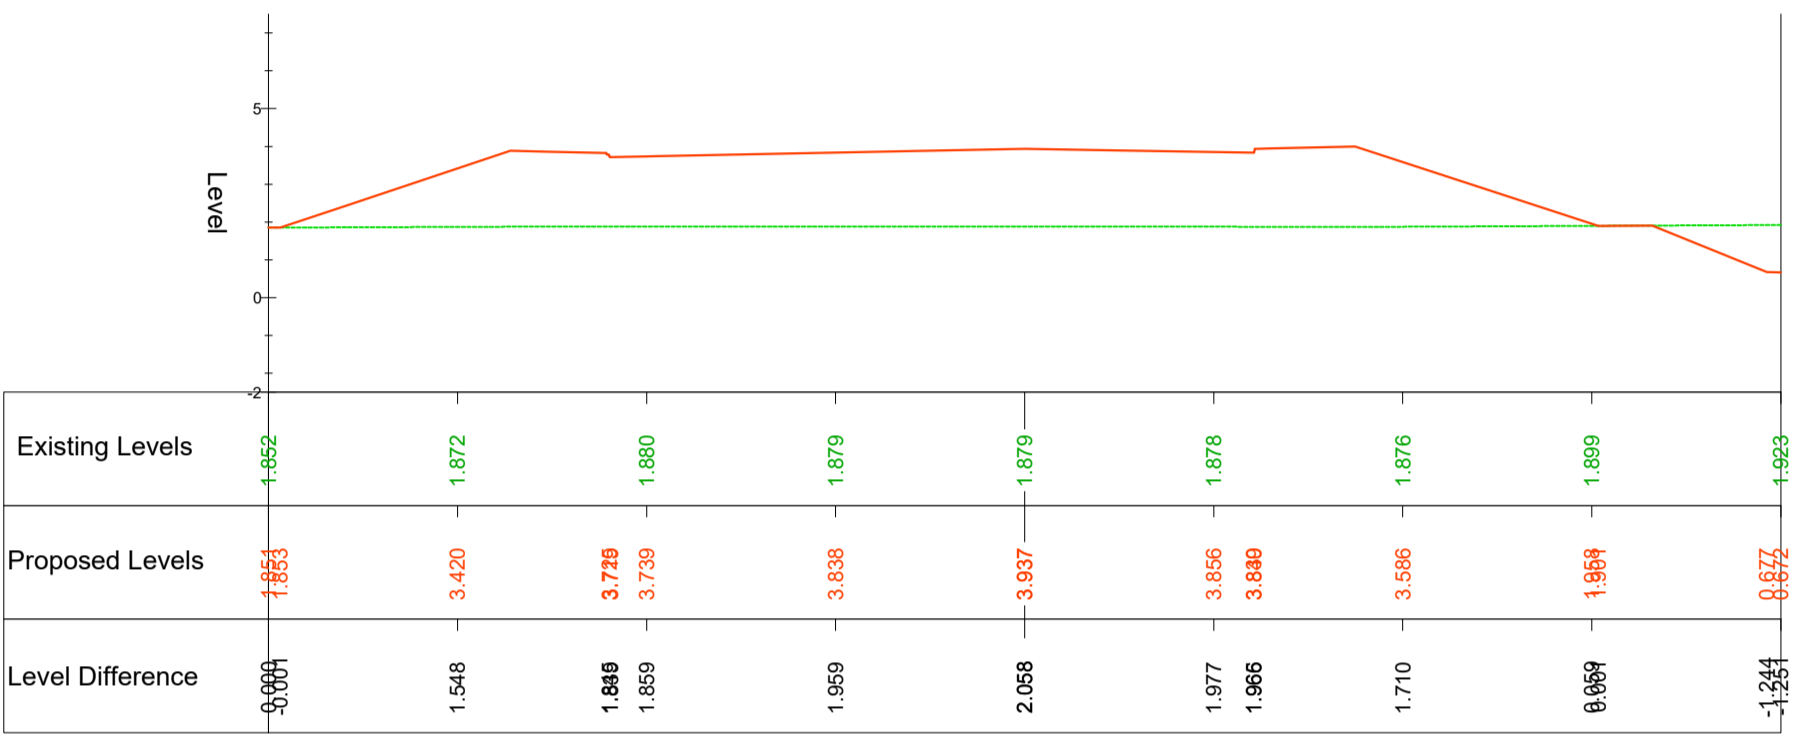

W Roundabout - CL - E Arm - Ch.280.00m


- NOTES:**
- THIS DRAWING IS TO BE READ IN CONJUNCTION WITH ALL OTHER RELEVANT ENGINEERS AND ARCHITECTS DRAWINGS.
  - DRAWINGS NOT TO BE SCALED.
  - REFER TO DRAWING NUMBER M181-AWP-01-01-DR-D-0321 - CROSS SECTION OVERVIEW FOR SPECIFIC CHAINAGE LOCATION.

**AS-BUILT DRAWING**

THIS DRAWING IS ISSUED FOR INCLUSION IN THE PROJECT AS-BUILT DOCUMENTATION AND THE INFORMATION INDICATED IS, TO THE BEST OF OUR KNOWLEDGE, REPRESENTATIVE OF THE CONSTRUCTED WORKS.

PLEASE NOTE, ALAN WOOD & PARTNERS HAVE NOT CARRIED OUT ANY SITE SUPERVISION OF THE PROJECT DURING CONSTRUCTION. THE CONTRACTOR IS DEEMED TO HAVE INSTALLED THE WORKS IN ACCORDANCE WITH THE CONSTRUCTION ISSUE DRAWINGS. UNLESS NOTED OTHERWISE ON THIS DRAWING OR CONFIRMED SEPARATELY BY THE CONTRACTOR IN WRITING, ALAN WOOD & PARTNERS ACCEPT NO LIABILITY FOR DEVIATIONS BETWEEN THESE DRAWINGS AND THE CONSTRUCTED WORKS. THE RESPONSIBILITY FOR WHICH LIES WHOLLY WITH THE CONTRACTOR.

|                               |          |     |     |     |
|-------------------------------|----------|-----|-----|-----|
| C02 CONSTRUCTION RECORD ISSUE | 29.08.25 | FM  | JEK | BH  |
| C01 FOR CONSTRUCTION          | 20.05.24 | GDV | BH  | BH  |
| Rev Description               | Date     | By  | Chk | App |

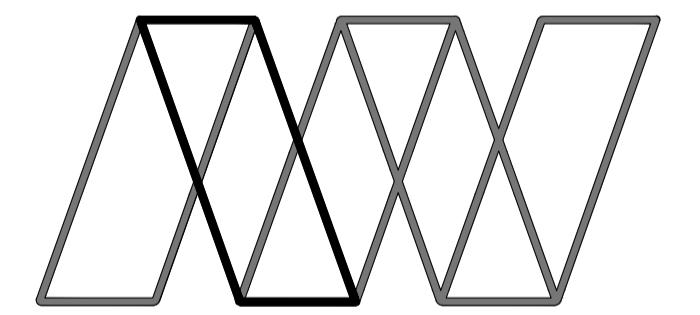

**Alan Wood & Partners**

York Office  
Omega 2  
Monks Cross Drive  
York  
YO32 9GZ

Consulting Civil & Structural Engineers  
Project Managers  
Building Surveyors

Hull  
Lincoln  
London  
Scarborough  
Sheffield  
Leeds

T. 01904 611594  
[www.alanwood.co.uk](http://www.alanwood.co.uk)


T. 01482 442138  
T. 01522 300210  
T. 02071 860761  
T. 01723 865484  
T. 01142 440077  
T. 01135 311098

|                                      |  |                  |          |      |        |
|--------------------------------------|--|------------------|----------|------|--------|
| Project:                             | M181/B1450 BURRINGHAM ROAD ROUNDABOUT        |                  |          |      |        |
| Client:                              | North Lincolnshire Council                   |                  |          |      |        |
| Drawing:                             | CROSS SECTION - CENTRAL ROUNDABOUT - SHEET 1 |                  |          |      |        |
| Role:                                | CIVIL ENGINEER                               |                  |          |      |        |
| Drawing Status:                      | CONSTRUCTION RECORD                          |                  |          |      |        |
| Job. no.:                            | 47603  | Scale@ A1: 1:200 | Rev. C02 |      |        |
| Project Originator                   | Volume                                       | Level            | Type     | Role | Number |
| M181 - AWP - 01 - 01 - DR - D - 0328 |  |                  |          |      |        |


**AS-BUILT DRAWING**

THIS DRAWING IS ISSUED FOR INCLUSION IN THE PROJECT AS-BUILT DOCUMENTATION AND THE INFORMATION INDICATED IS, TO THE BEST OF OUR KNOWLEDGE, REPRESENTATIVE OF THE CONSTRUCTED WORKS.

PLEASE NOTE, ALAN WOOD & PARTNERS HAVE NOT CARRIED OUT ANY SITE SUPERVISION OF THE PROJECT DURING CONSTRUCTION. THE CONTRACTOR IS DEEMED TO HAVE INSTALLED THE WORKS IN ACCORDANCE WITH THE CONSTRUCTION ISSUE DRAWINGS, UNLESS NOTED OTHERWISE ON THIS DRAWING OR CONFIRMED SEPARATELY BY THE CONTRACTOR IN WRITING. ALAN WOOD & PARTNERS ACCEPT NO LIABILITY FOR DEVIATIONS BETWEEN THESE DRAWINGS AND THE CONSTRUCTED WORKS. THE RESPONSIBILITY FOR WHICH LIES WHOLLY WITH THE CONTRACTOR.

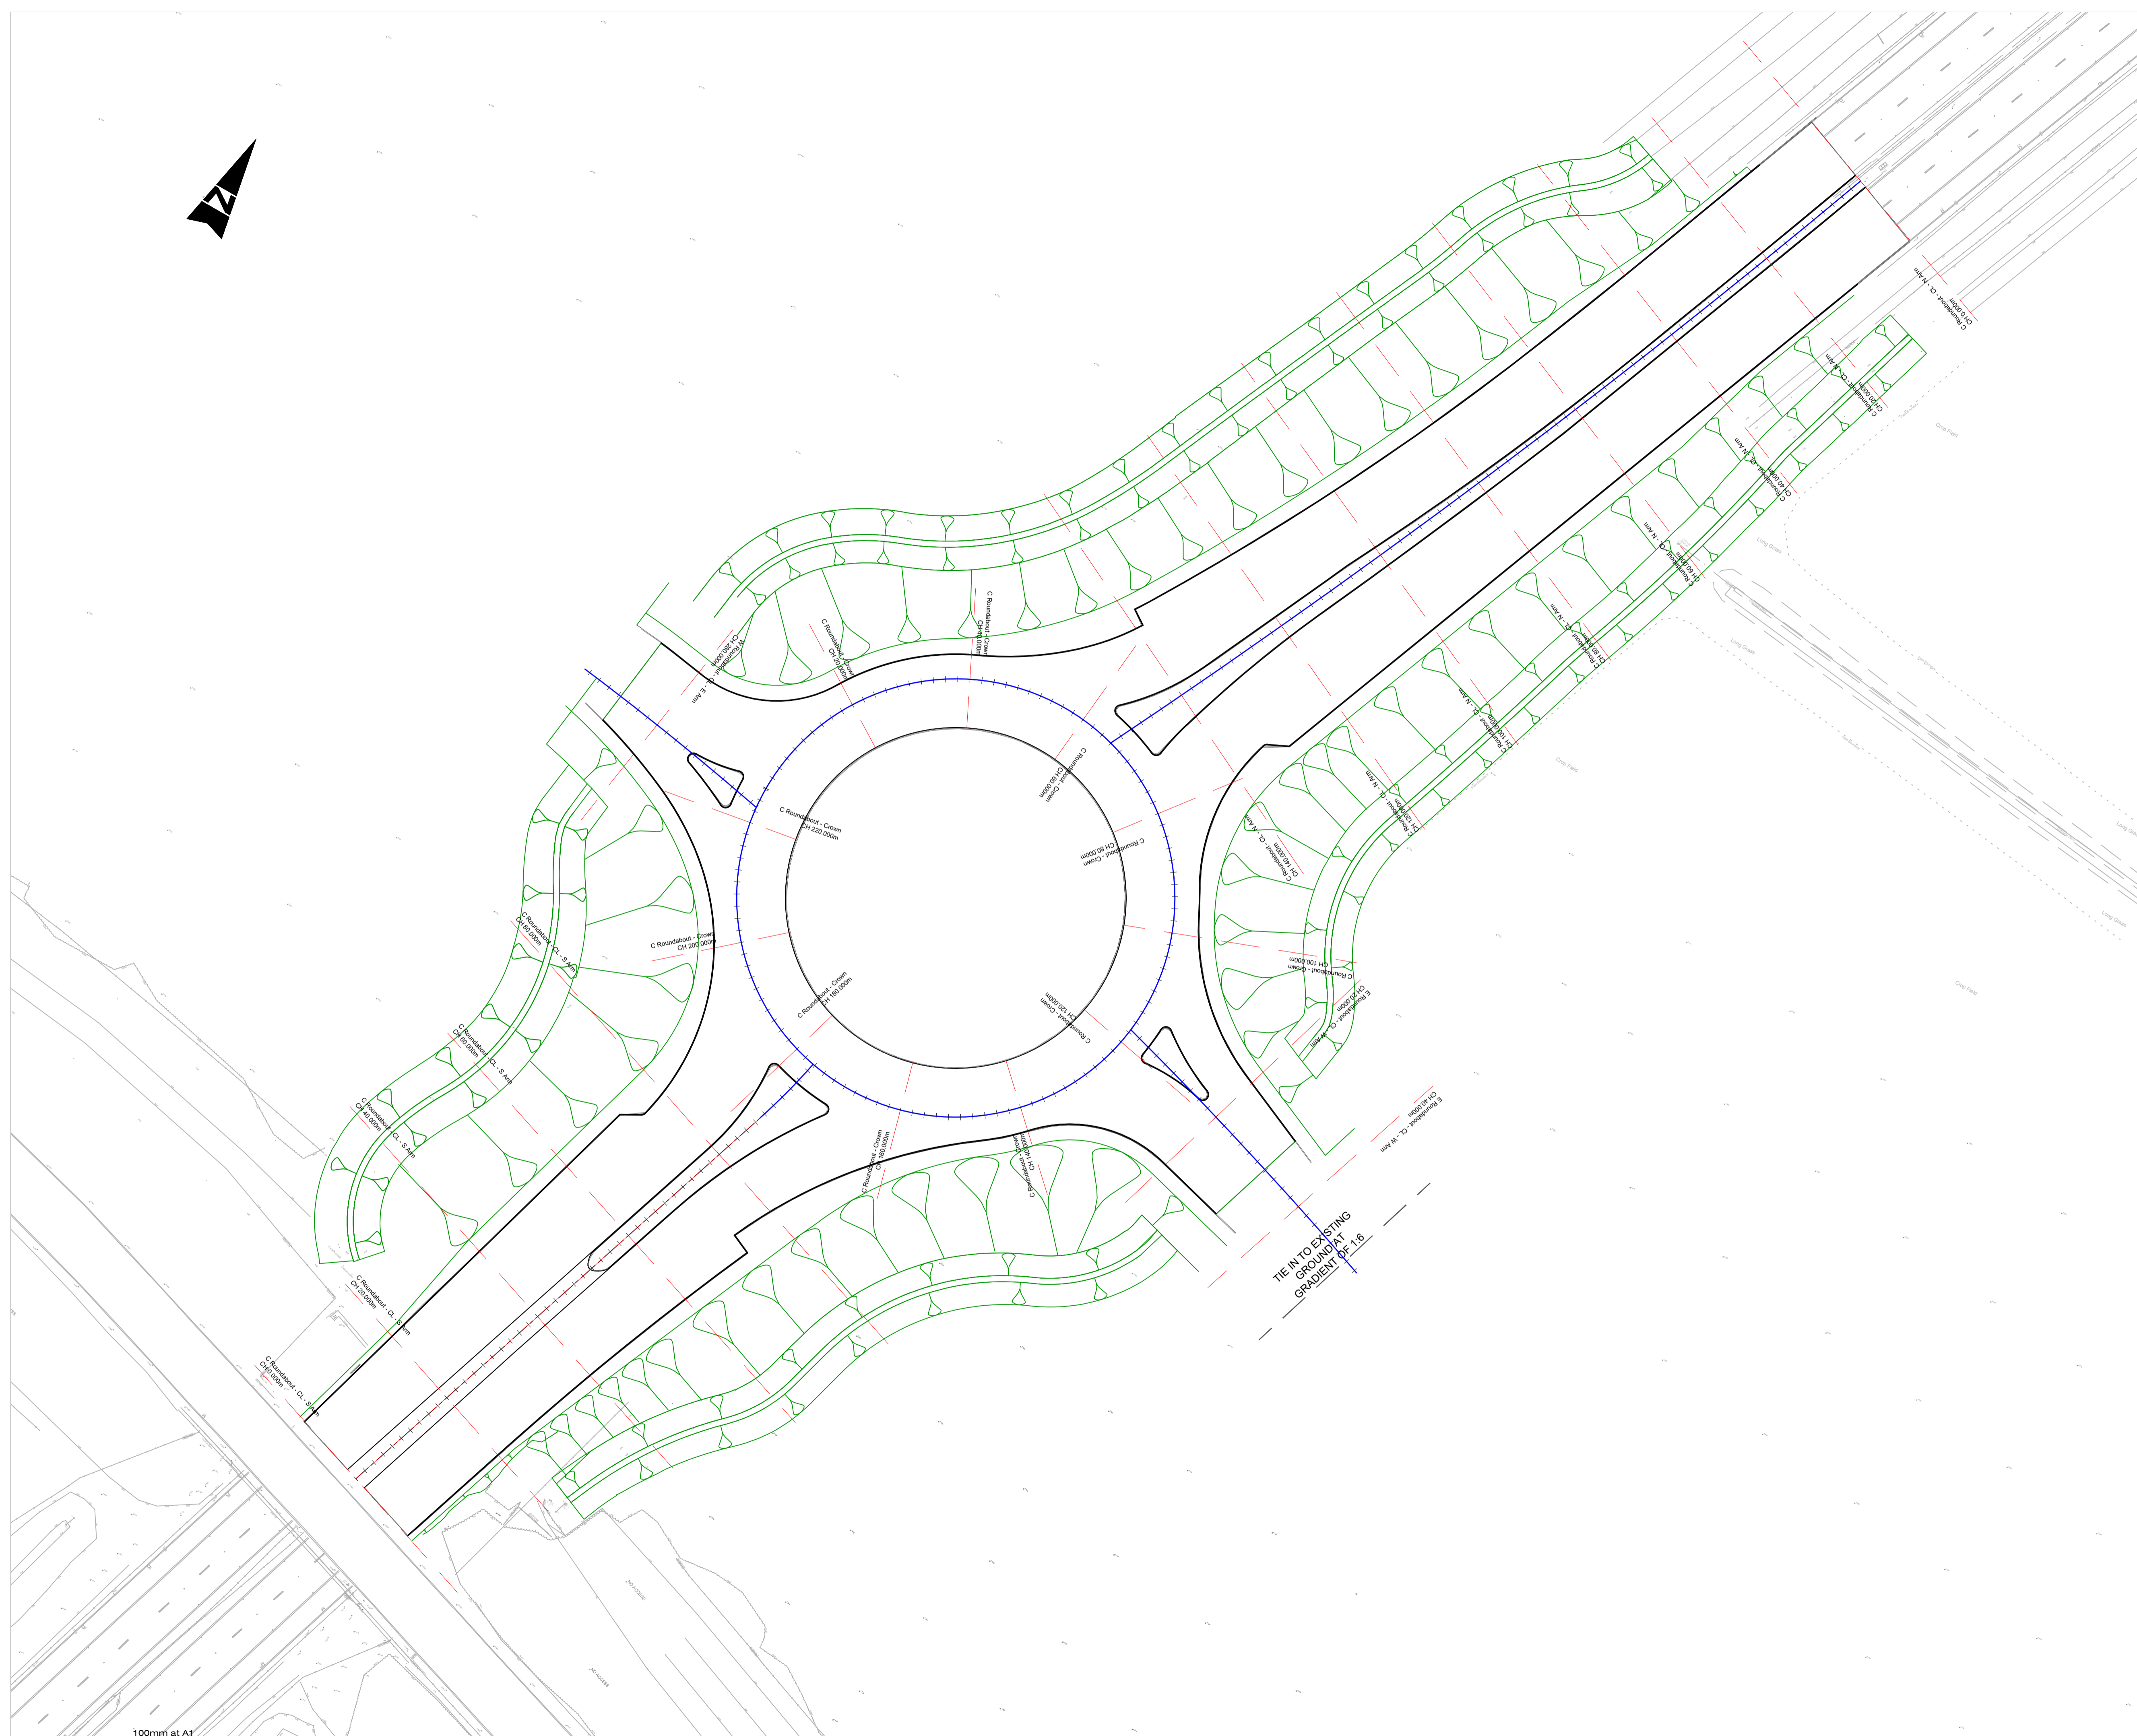

|     |                           |          |     |     |     |
|-----|---------------------------|----------|-----|-----|-----|
| Rev | Description               | Date     | By  | Chk | App |
| C02 | CONSTRUCTION RECORD ISSUE | 29.08.25 | FM  | JEK | BH  |
| C01 | FOR CONSTRUCTION          | 20.05.24 | GDV | BH  | BH  |

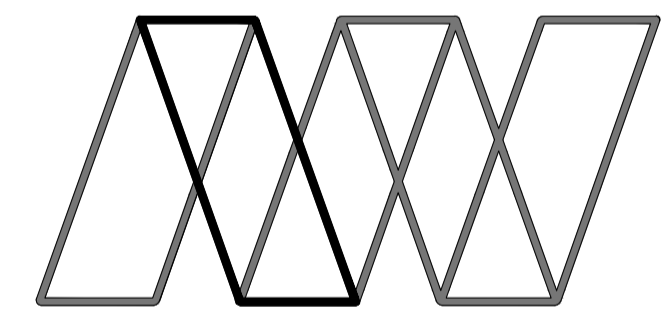


**Alan Wood & Partners**


**York Office**  
 Omega 2  
 Monks Cross Drive  
 York  
 YO32 9GZ  
  
 T. 01904 611594  
 www.alanwood.co.uk

**Consulting Civil & Structural Engineers**  
**Project Managers**  
**Building Surveyors**  
  
 Hull T. 01482 442138  
 Lincoln T. 01522 300210  
 London T. 02071 860761  
 Scarborough T. 01723 865484  
 Sheffield T. 01142 440077  
 Leeds T. 01135 311098


|  |                                       |            |       |      |     |
|--|---------------------------------------|------------|-------|------|-----|
| Project:   | M181/B1450 BURRINGHAM ROAD ROUNDABOUT |            |       |      |     |
| Client:  | North Lincolnshire Council            |            |       |      |     |
| Drawing:   | CROSS SECTION OVERVIEW PLAN           |            |       |      |     |
| Role:  | CIVIL ENGINEER                        |            |       |      |     |
| Drawing Status:  | CONSTRUCTION RECORD                   |            |       |      |     |
| Job. no.   | 47603                                 | Scale@ A1: | 1:500 | Rev. | C02 |
| Project Originator Volume Level Type Role Number<br>M181 - AWP - 01 - 01 - DR - D - 0321 |                                       |            |       |      |     |

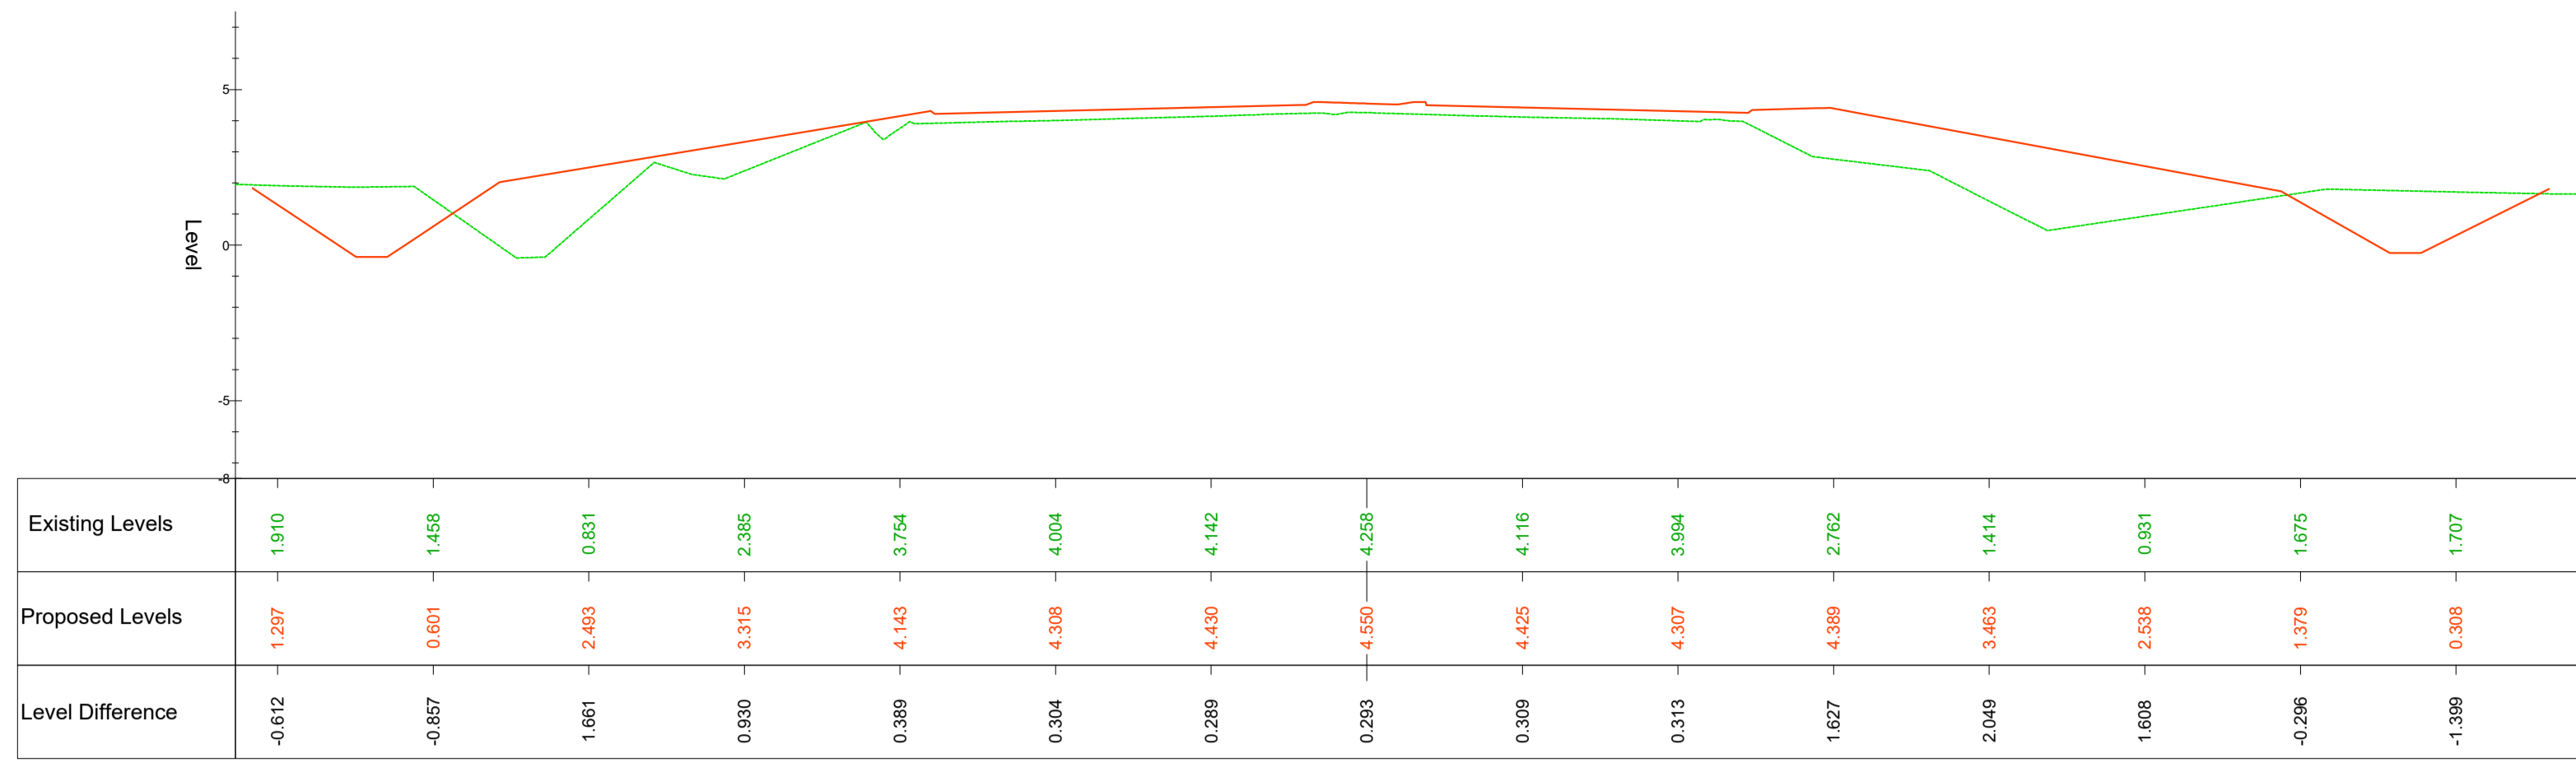


C Roundabout - CL - N Arm - Ch.80.00m

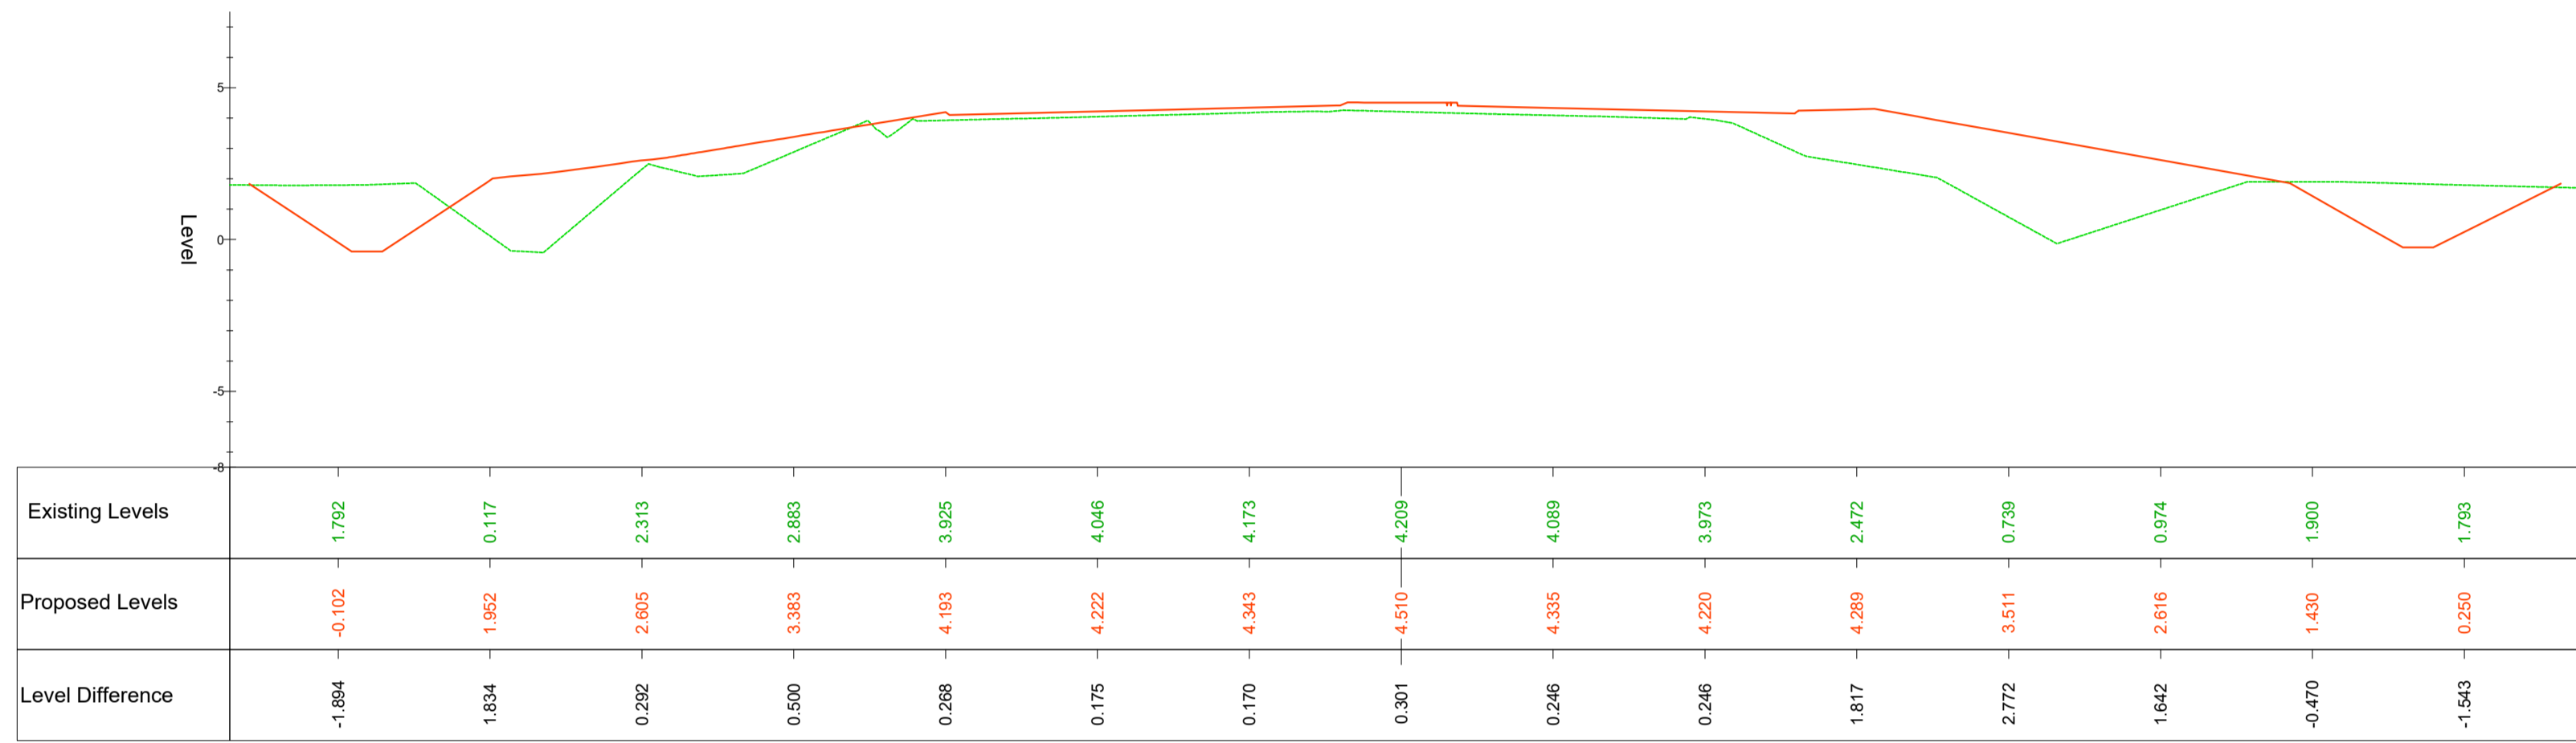

C Roundabout - CL - N Arm - Ch.100.00m

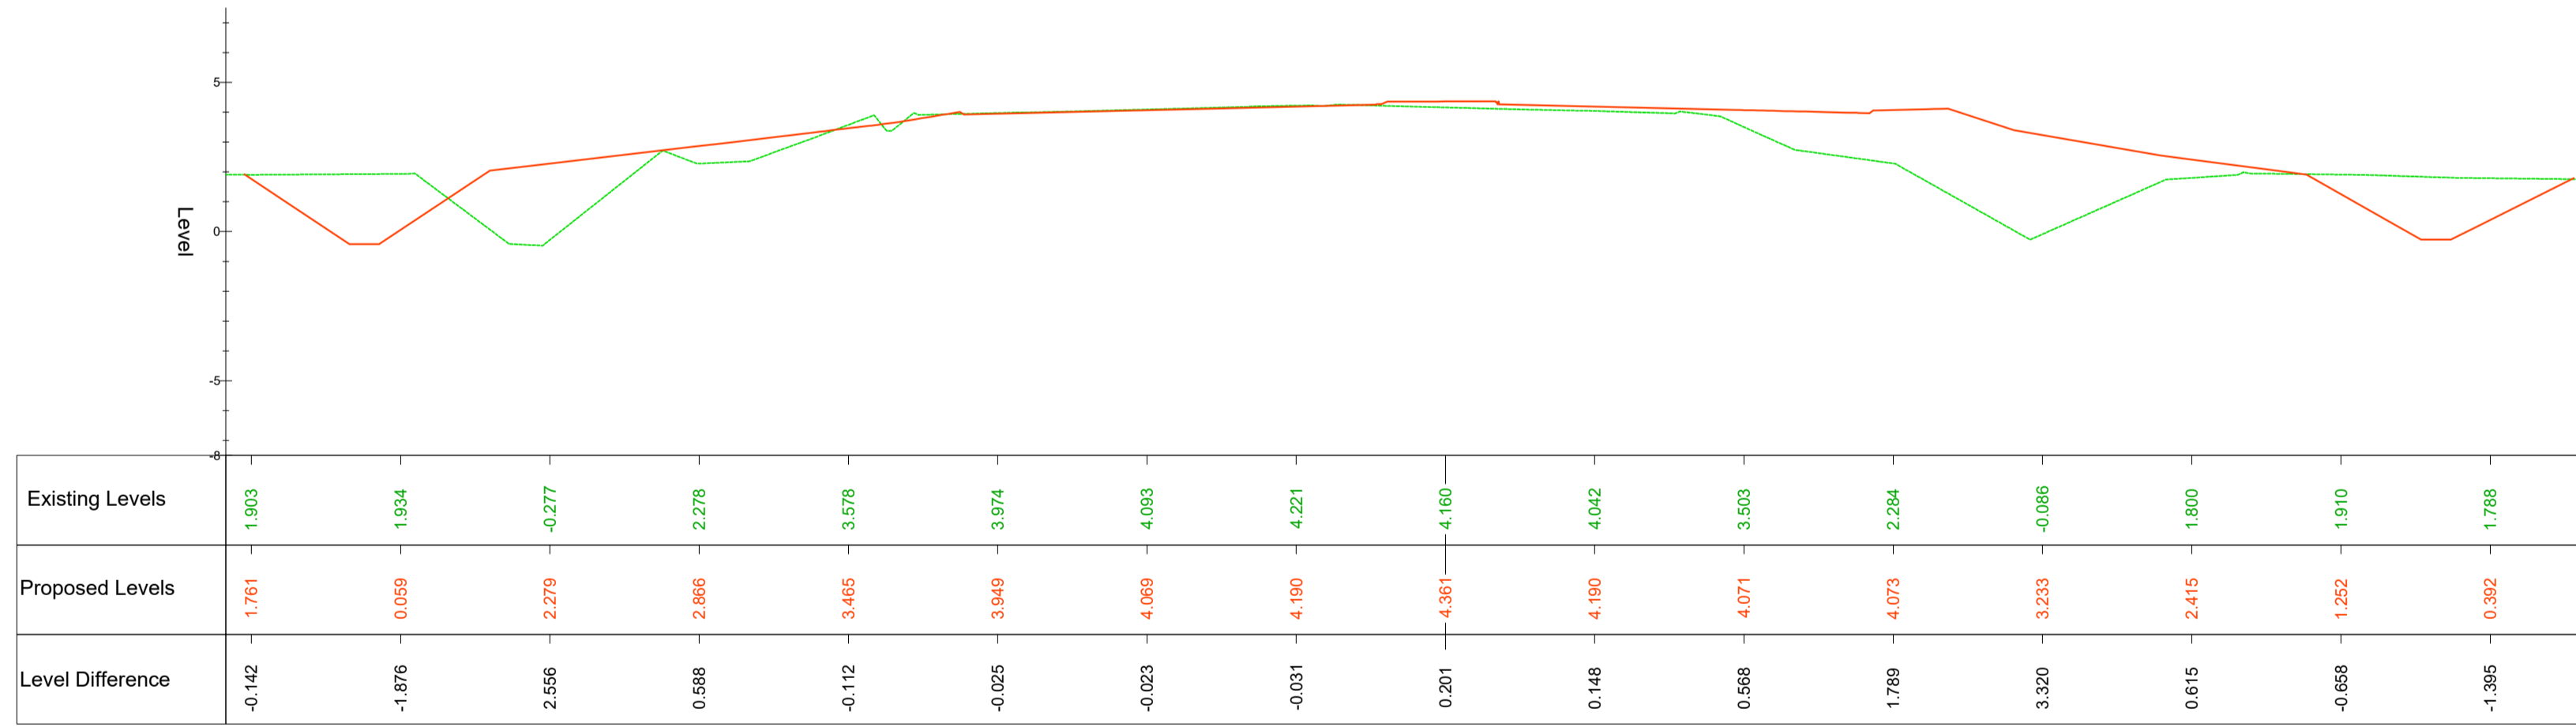

C Roundabout - CL - N Arm - Ch.120.00m

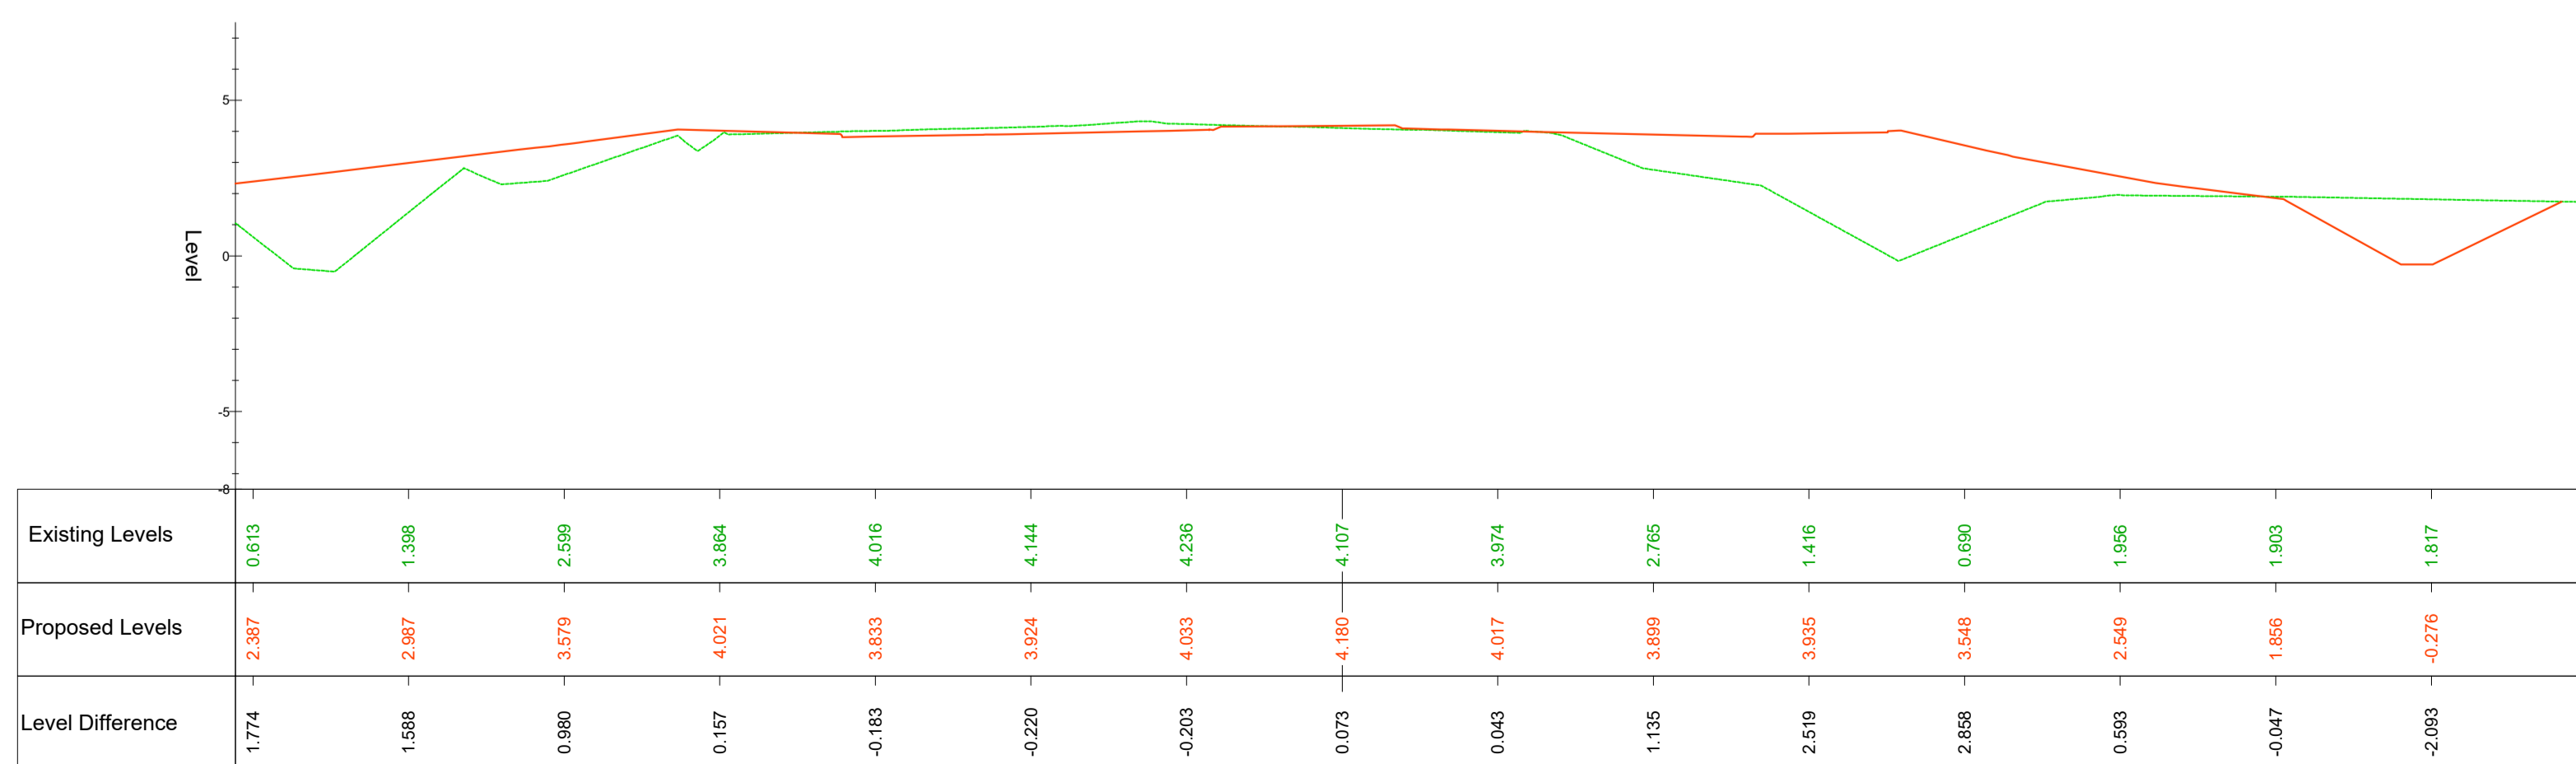

C Roundabout - CL - N Arm - Ch.140.00m

100mm at A1


- NOTES:**
- THIS DRAWING IS TO BE READ IN CONJUNCTION WITH ALL OTHER RELEVANT ENGINEERS AND ARCHITECTS DRAWINGS.
  - DRAWINGS NOT TO BE SCALED.
  - REFER TO DRAWING NUMBER M181-AWP-01-01-DR-D-0321 - CROSS SECTION OVERVIEW FOR SPECIFIC CHAINAGE LOCATION.

**AS-BUILT DRAWING**

THIS DRAWING IS ISSUED FOR INCLUSION IN THE PROJECT AS-BUILT DOCUMENTATION AND THE INFORMATION INDICATED IS, TO THE BEST OF OUR KNOWLEDGE, REPRESENTATIVE OF THE CONSTRUCTED WORKS.

PLEASE NOTE: ALAN WOOD & PARTNERS HAVE NOT CARRIED OUT ANY SITE SUPERVISION OF THE PROJECT DURING CONSTRUCTION. THE CONTRACTOR IS DEEMED TO HAVE INSTALLED THE WORKS IN ACCORDANCE WITH THE CONSTRUCTION ISSUE DRAWINGS. UNLESS NOTED OTHERWISE ON THIS DRAWING OR CONFIRMED SEPARATELY BY THE CONTRACTOR IN WRITING, ALAN WOOD & PARTNERS ACCEPT NO LIABILITY FOR DEVIATIONS BETWEEN THESE DRAWINGS AND THE CONSTRUCTED WORKS. THE RESPONSIBILITY FOR WHICH LIES WHOLLY WITH THE CONTRACTOR.




|                               |          |     |     |     |
|-------------------------------|----------|-----|-----|-----|
| C02 CONSTRUCTION RECORD ISSUE | 29.08.25 | FM  | JEK | BH  |
| C01 FOR CONSTRUCTION          | 20.05.24 | GDV | BH  | BH  |
| Rev/Description               | Date     | By  | Chk | App |

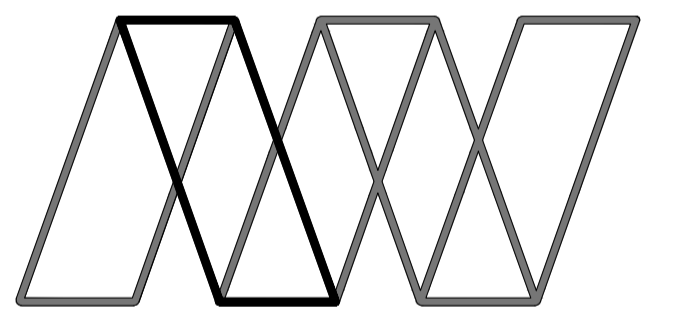

**Alan Wood & Partners**

|  |  |
|--|--|
| <p>York Office<br/>Omega 2<br/>Monks Cross Drive<br/>York<br/>YO32 9GZ</p> <p>T. 01904 611594<br/>www.alanwood.co.uk</p> | <p>Consulting Civil<br/>&amp; Structural Engineers<br/>Project Managers<br/>Building Surveyors</p> <p>Hull<br/>Lincoln<br/>London<br/>Scarborough<br/>Sheffield<br/>Leeds</p> <p>T. 01482 442138<br/>T. 01522 300210<br/>T. 02071 860761<br/>T. 01723 865484<br/>T. 01142 440077<br/>T. 01135 311098</p> |
|--|--|




|                    |  |            |       |       |     |      |  |      |  |        |  |
|--------------------|--|------------|-------|-------|-----|------|--|------|--|--------|--|
| Project:           | M181/B1450 BURRINGHAM ROAD ROUNDABOUT        |            |       |       |     |      |  |      |  |        |  |
| Client:            | North Lincolnshire Council                   |            |       |       |     |      |  |      |  |        |  |
| Drawing:           | CROSS SECTION - CENTRAL ROUNDABOUT - SHEET 2 |            |       |       |     |      |  |      |  |        |  |
| Role:              | CIVIL ENGINEER                               |            |       |       |     |      |  |      |  |        |  |
| Drawing Status:    | CONSTRUCTION RECORD                          |            |       |       |     |      |  |      |  |        |  |
| Job. no.           | 47603  | Scale@ A1: | 1:200 | Rev.  | C02 |      |  |      |  |        |  |
| Project Originator | M181 - AWP - 01 - 01 - DR - D - 0329         | Volume     |       | Level |     | Type |  | Role |  | Number |  |

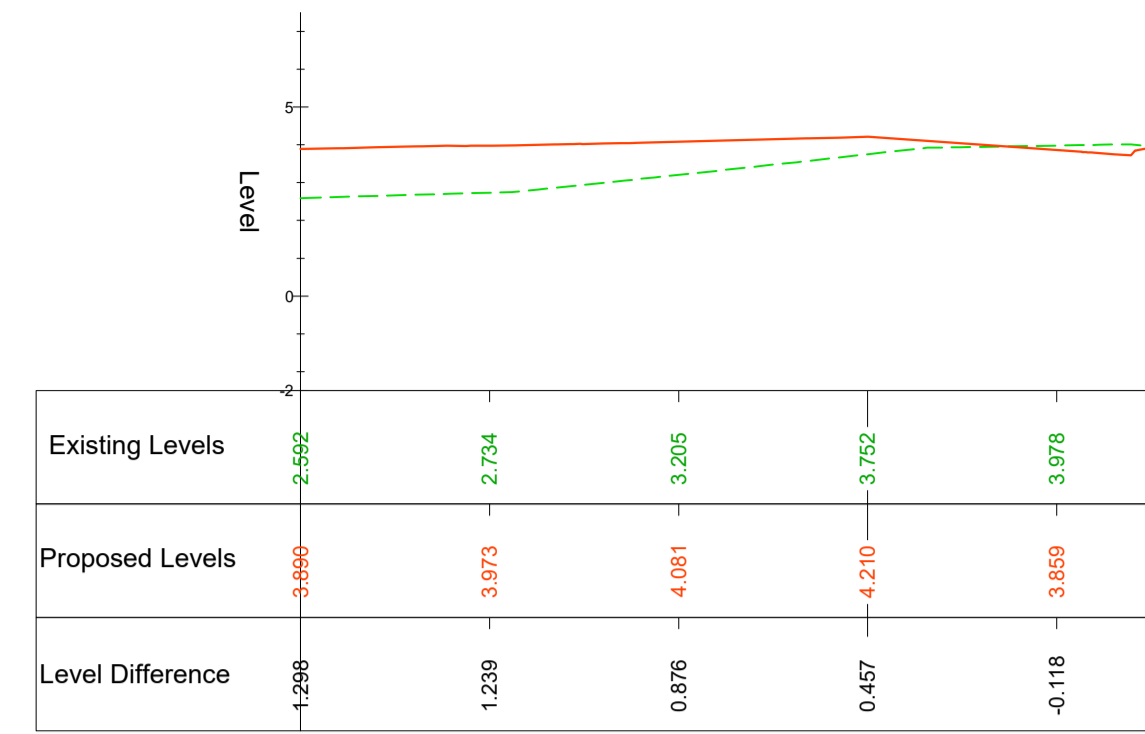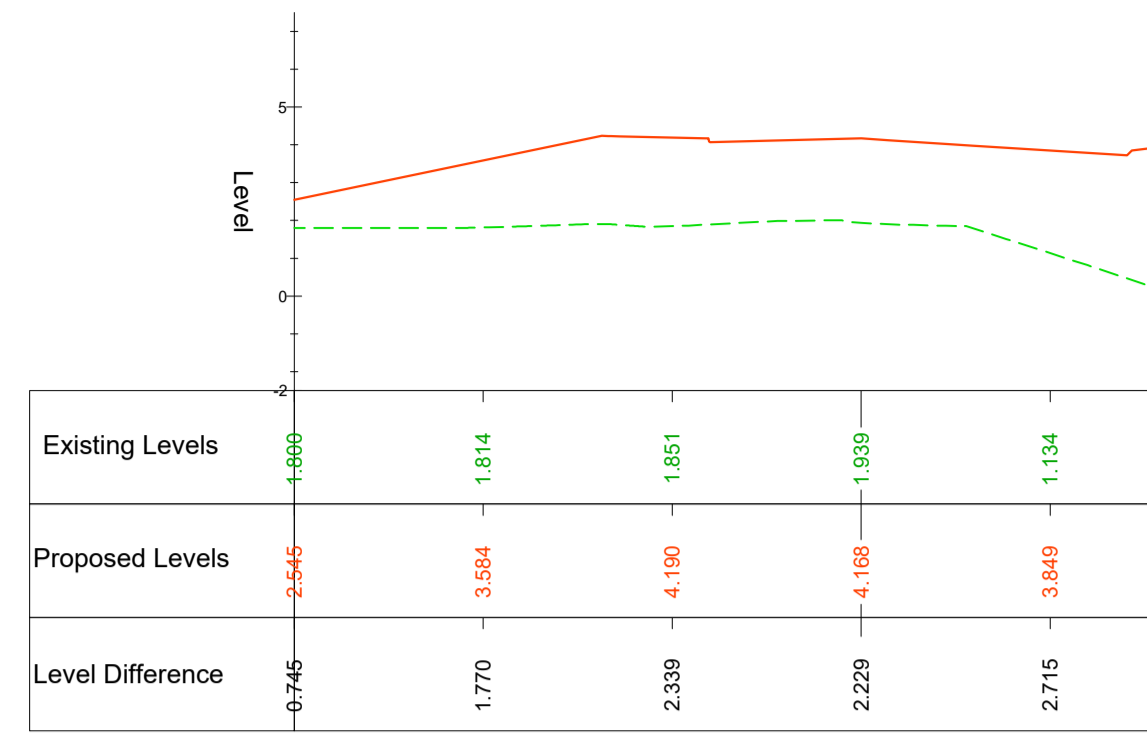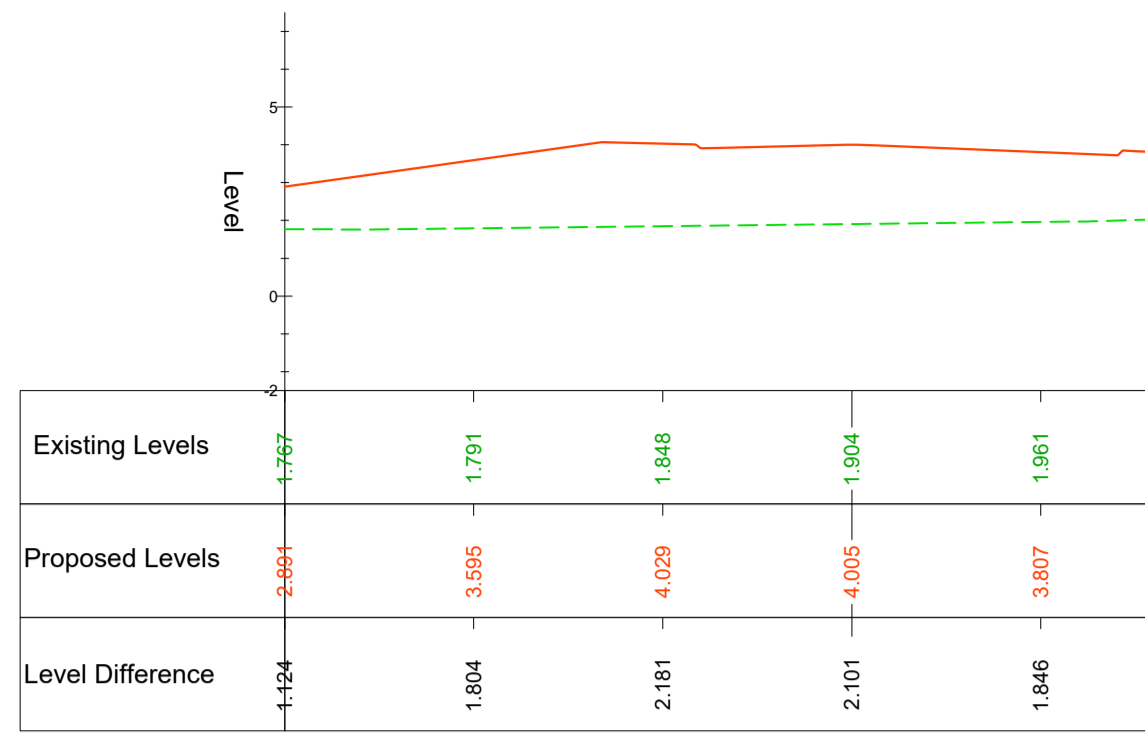

C Roundabout - Crown - Ch.20.00m

C Roundabout - Crown - Ch.40.00m




C Roundabout - Crown - Ch.60.00m

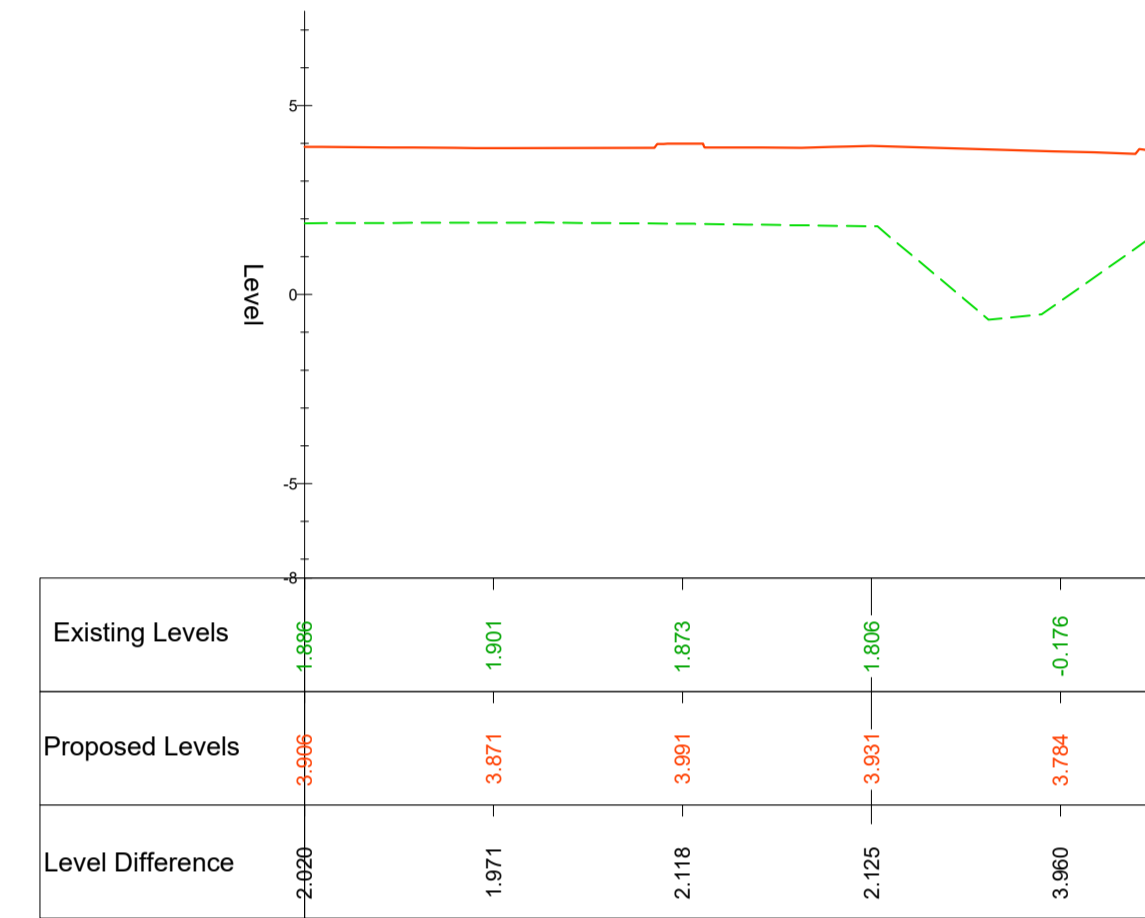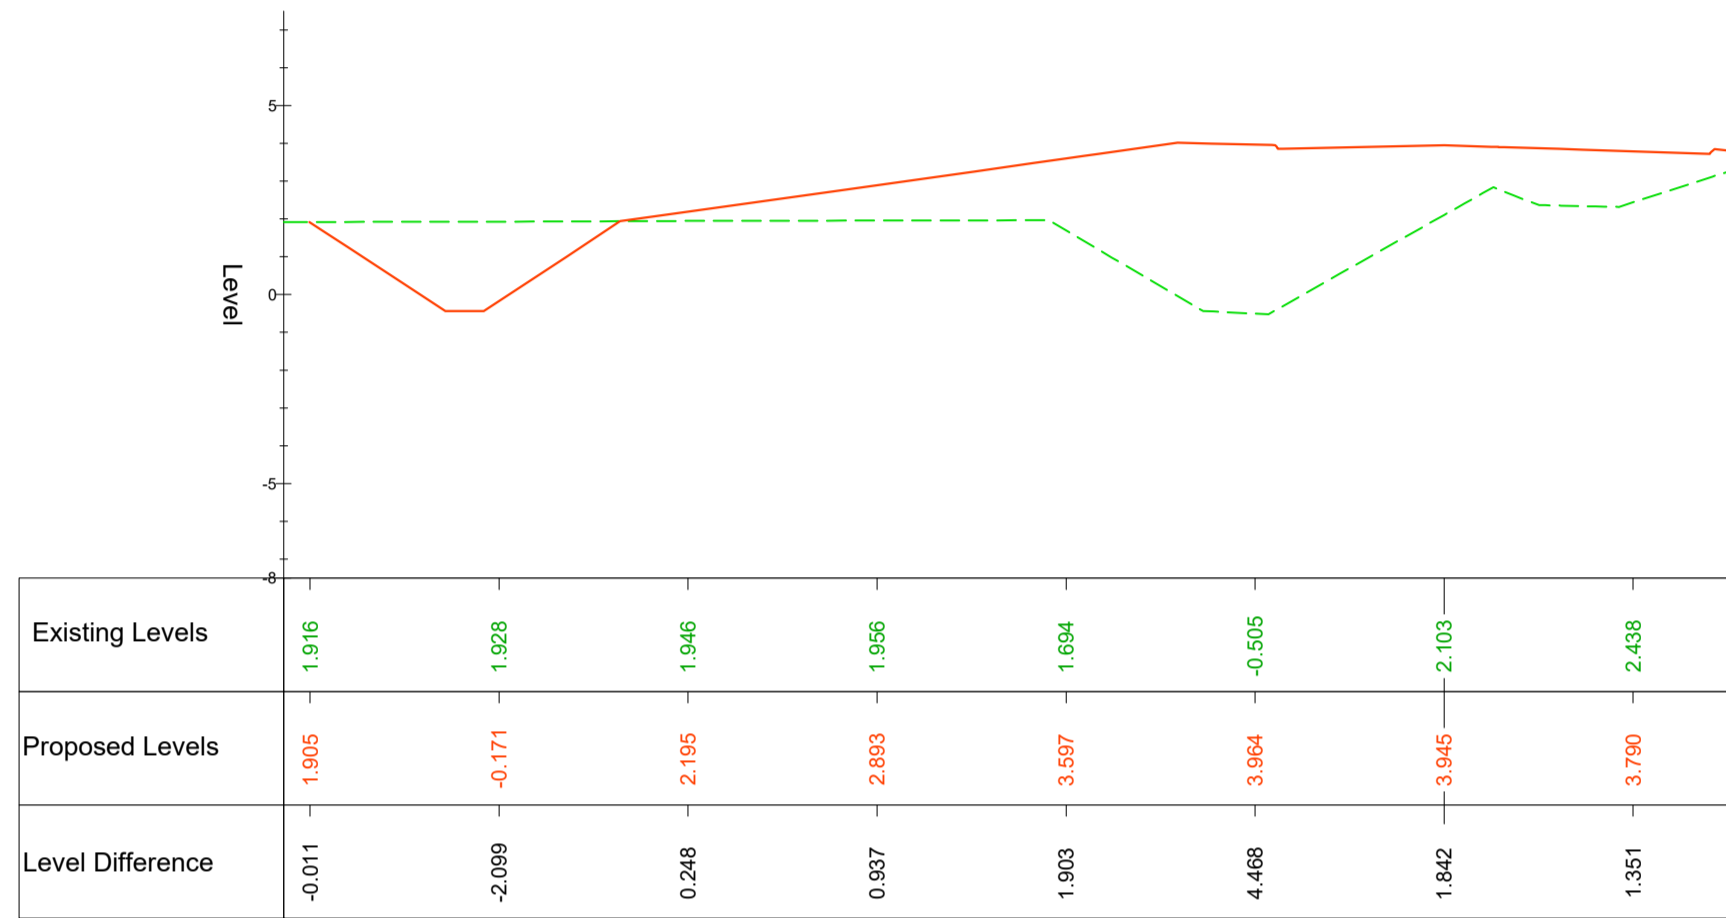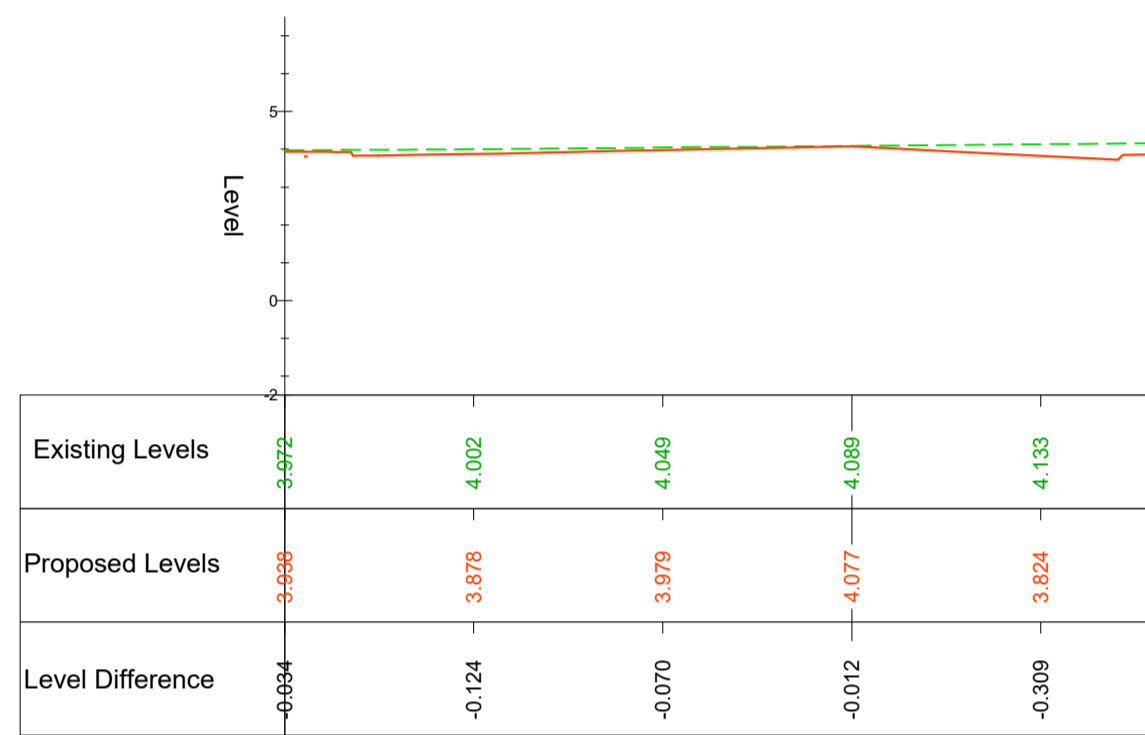

C Roundabout - Crown - Ch.80.00m

C Roundabout - Crown - Ch.100.00m



C Roundabout - Crown - Ch.120.00m

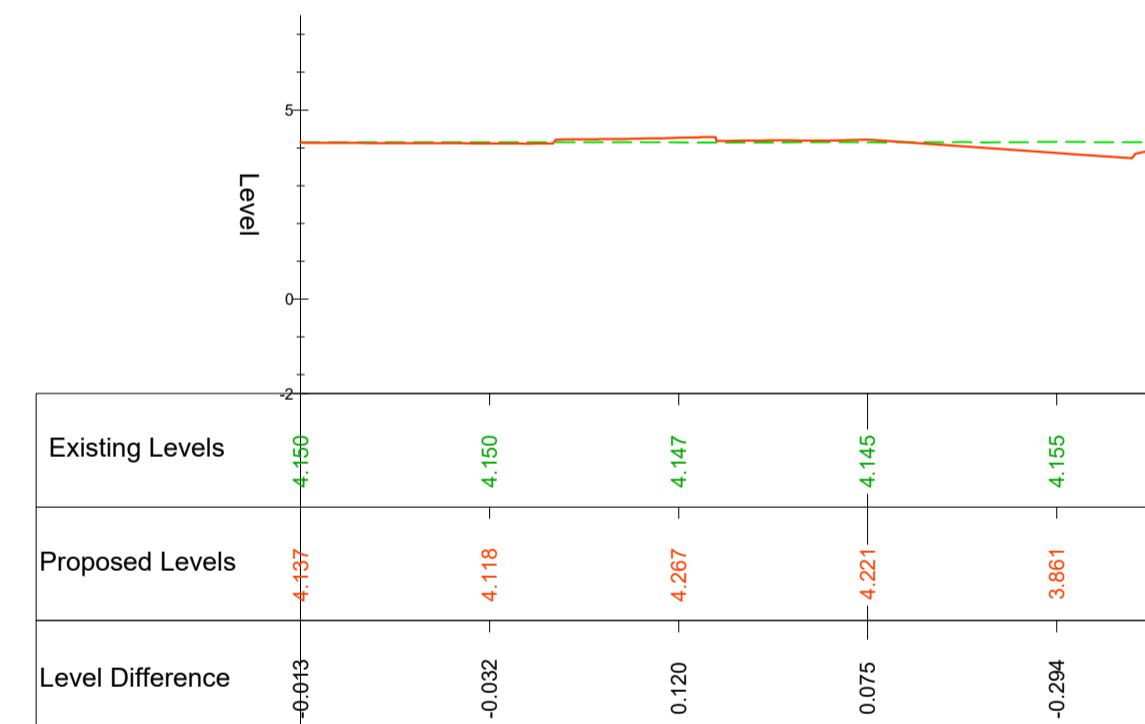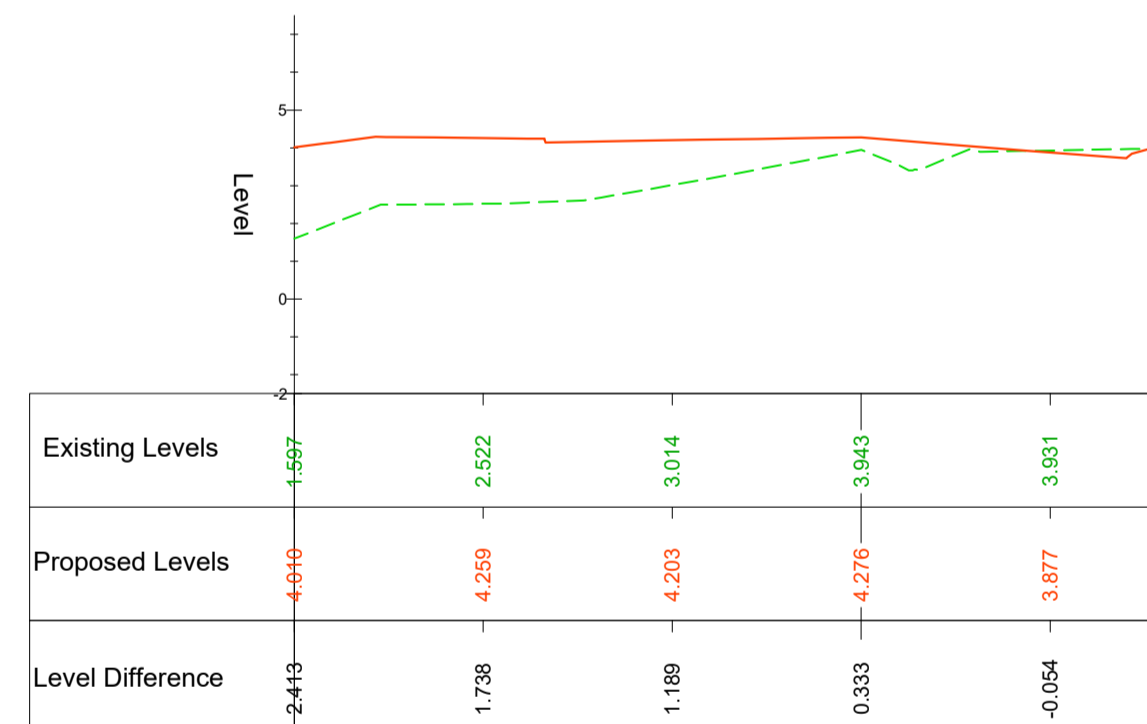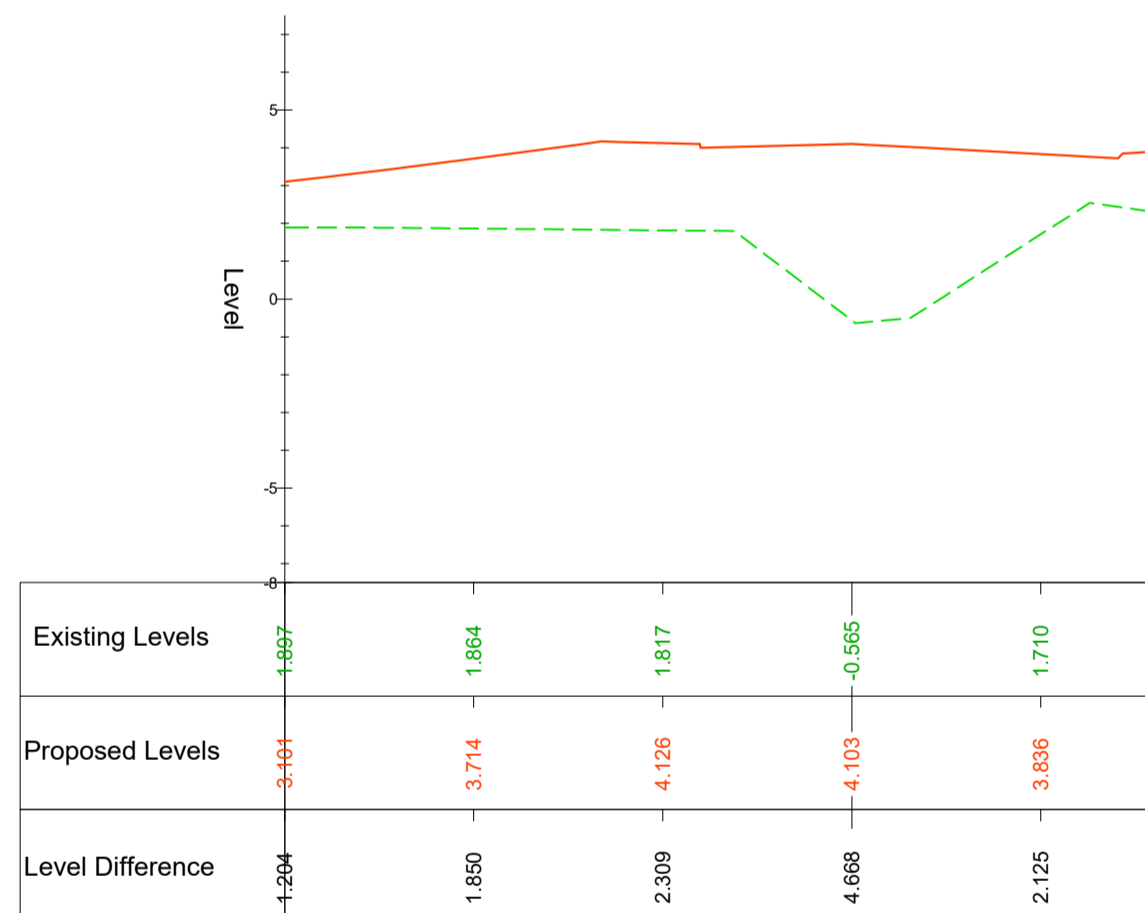

C Roundabout - Crown - Ch.140.00m

C Roundabout - Crown - Ch.160.00m

C Roundabout - Crown - Ch.180.00m

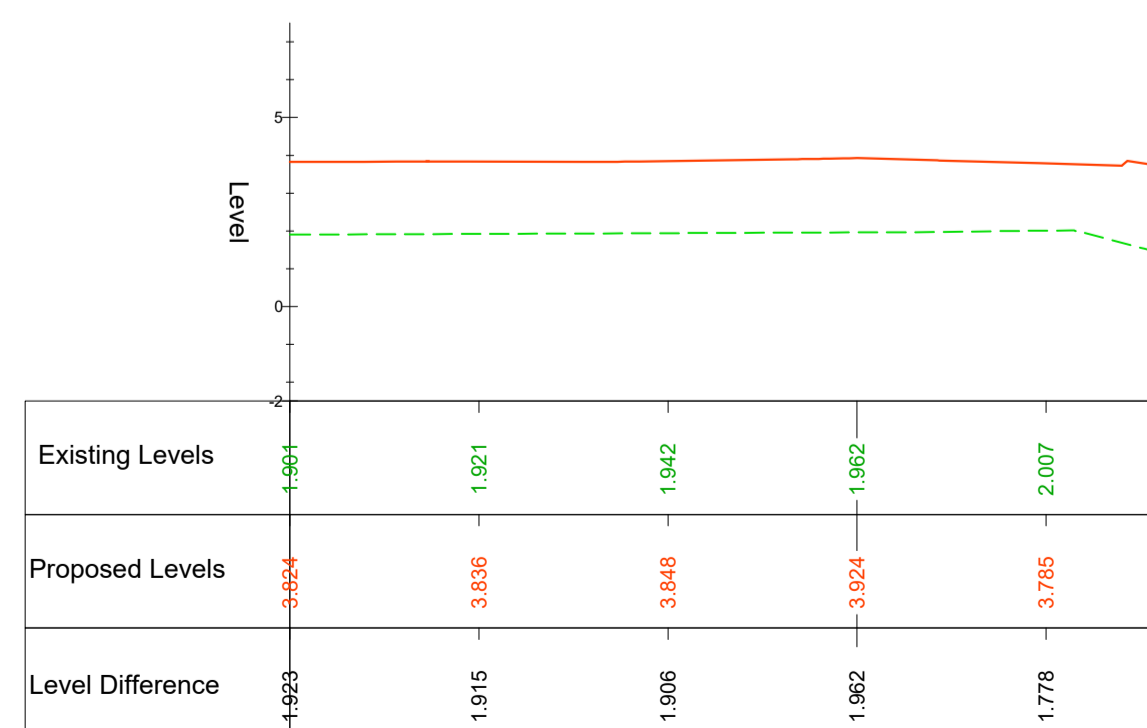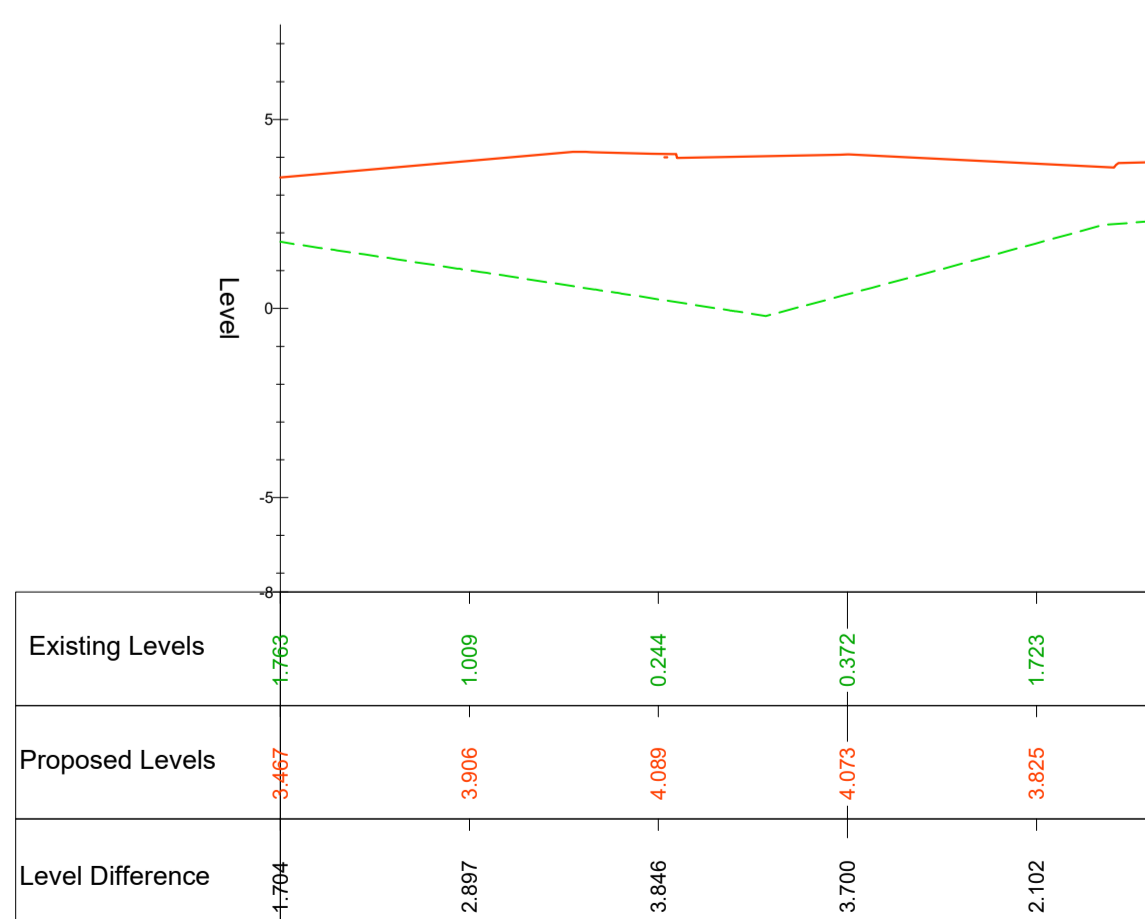

C Roundabout - Crown - Ch.200.00m

C Roundabout - Crown - Ch.220.00m


- NOTES:**
- THIS DRAWING IS TO BE READ IN CONJUNCTION WITH ALL OTHER RELEVANT ENGINEERS AND ARCHITECTS DRAWINGS.
  - DRAWINGS NOT TO BE SCALED.
  - REFER TO DRAWING NUMBER M181-AWP-01-01-DR-D-0321 - CROSS SECTION OVERVIEW FOR SPECIFIC CHAINAGE LOCATION.

**AS-BUILT DRAWING**

THIS DRAWING IS ISSUED FOR INCLUSION IN THE PROJECT AS-BUILT DOCUMENTATION AND THE INFORMATION INDICATED IS, TO THE BEST OF OUR KNOWLEDGE, REPRESENTATIVE OF THE CONSTRUCTED WORKS.

PLEASE NOTE, ALAN WOOD & PARTNERS HAVE NOT CARRIED OUT ANY SITE SUPERVISION OF THE PROJECT DURING CONSTRUCTION. THE CONTRACTOR IS DEEMED TO HAVE INSTALLED THE WORKS IN ACCORDANCE WITH THE CONSTRUCTION ISSUE DRAWINGS. UNLESS NOTED OTHERWISE ON THIS DRAWING OR CONFIRMED SEPARATELY BY THE CONTRACTOR IN WRITING, ALAN WOOD & PARTNERS ACCEPT NO LIABILITY FOR DEVIATIONS BETWEEN THESE DRAWINGS AND THE CONSTRUCTED WORKS. THE RESPONSIBILITY FOR WHICH LIES WHOLLY WITH THE CONTRACTOR.



|                               |             |      |     |     |     |
|-------------------------------|-------------|------|-----|-----|-----|
| C02 CONSTRUCTION RECORD ISSUE | 29.08.25    | FM   | JEK | BH  |     |
| C01 FOR CONSTRUCTION          | 20.05.24    | GDV  | BH  | BH  |     |
| Rev                           | Description | Date | By  | Chk | App |

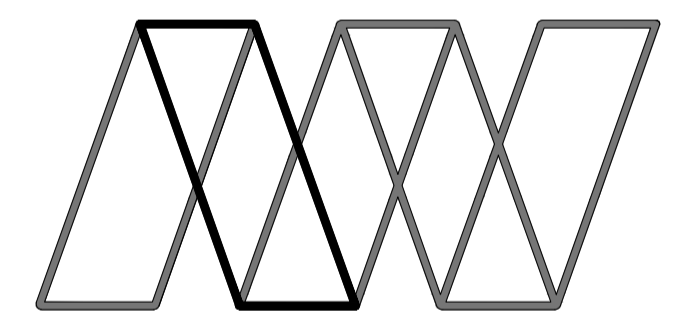

**Alan Wood & Partners**

|   |  |
|---|--|
| <b>York Office</b><br>Omega 2<br>Monks Cross Drive<br>York<br>YO32 9GZ<br><br>T. 01904 611594<br>www.alanwood.co.uk | <b>Consulting Civil &amp; Structural Engineers</b><br>Project Managers<br>Building Surveyors<br><br>Hull<br>Lincoln<br>London<br>Scarborough<br>Sheffield<br>Leeds<br><br>T. 01482 442138<br>T. 01522 300210<br>T. 02071 860761<br>T. 01723 865484<br>T. 01142 440077<br>T. 01135 311098 |
|---|--|

|                                      |  |            |       |      |      |        |
|--------------------------------------|--|------------|-------|------|------|--------|
| Project:                             | M181/B1450 BURRINGHAM ROAD ROUNDABOUT        |            |       |      |      |        |
| Client:                              | North Lincolnshire Council                   |            |       |      |      |        |
| Drawing:                             | CROSS SECTION - CENTRAL ROUNDABOUT - SHEET 4 |            |       |      |      |        |
| Role:                                | CIVIL ENGINEER                               |            |       |      |      |        |
| Drawing Status:                      | CONSTRUCTION RECORD                          |            |       |      |      |        |
| Job. no.                             | 47603  | Scale@ A1: | 1:200 | Rev. | C02  |        |
| Project                              | Originator                                   | Volume     | Level | Type | Role | Number |
| M181 - AWP - 01 - 01 - DR - D - 0331 |  |            |       |      |      |        |

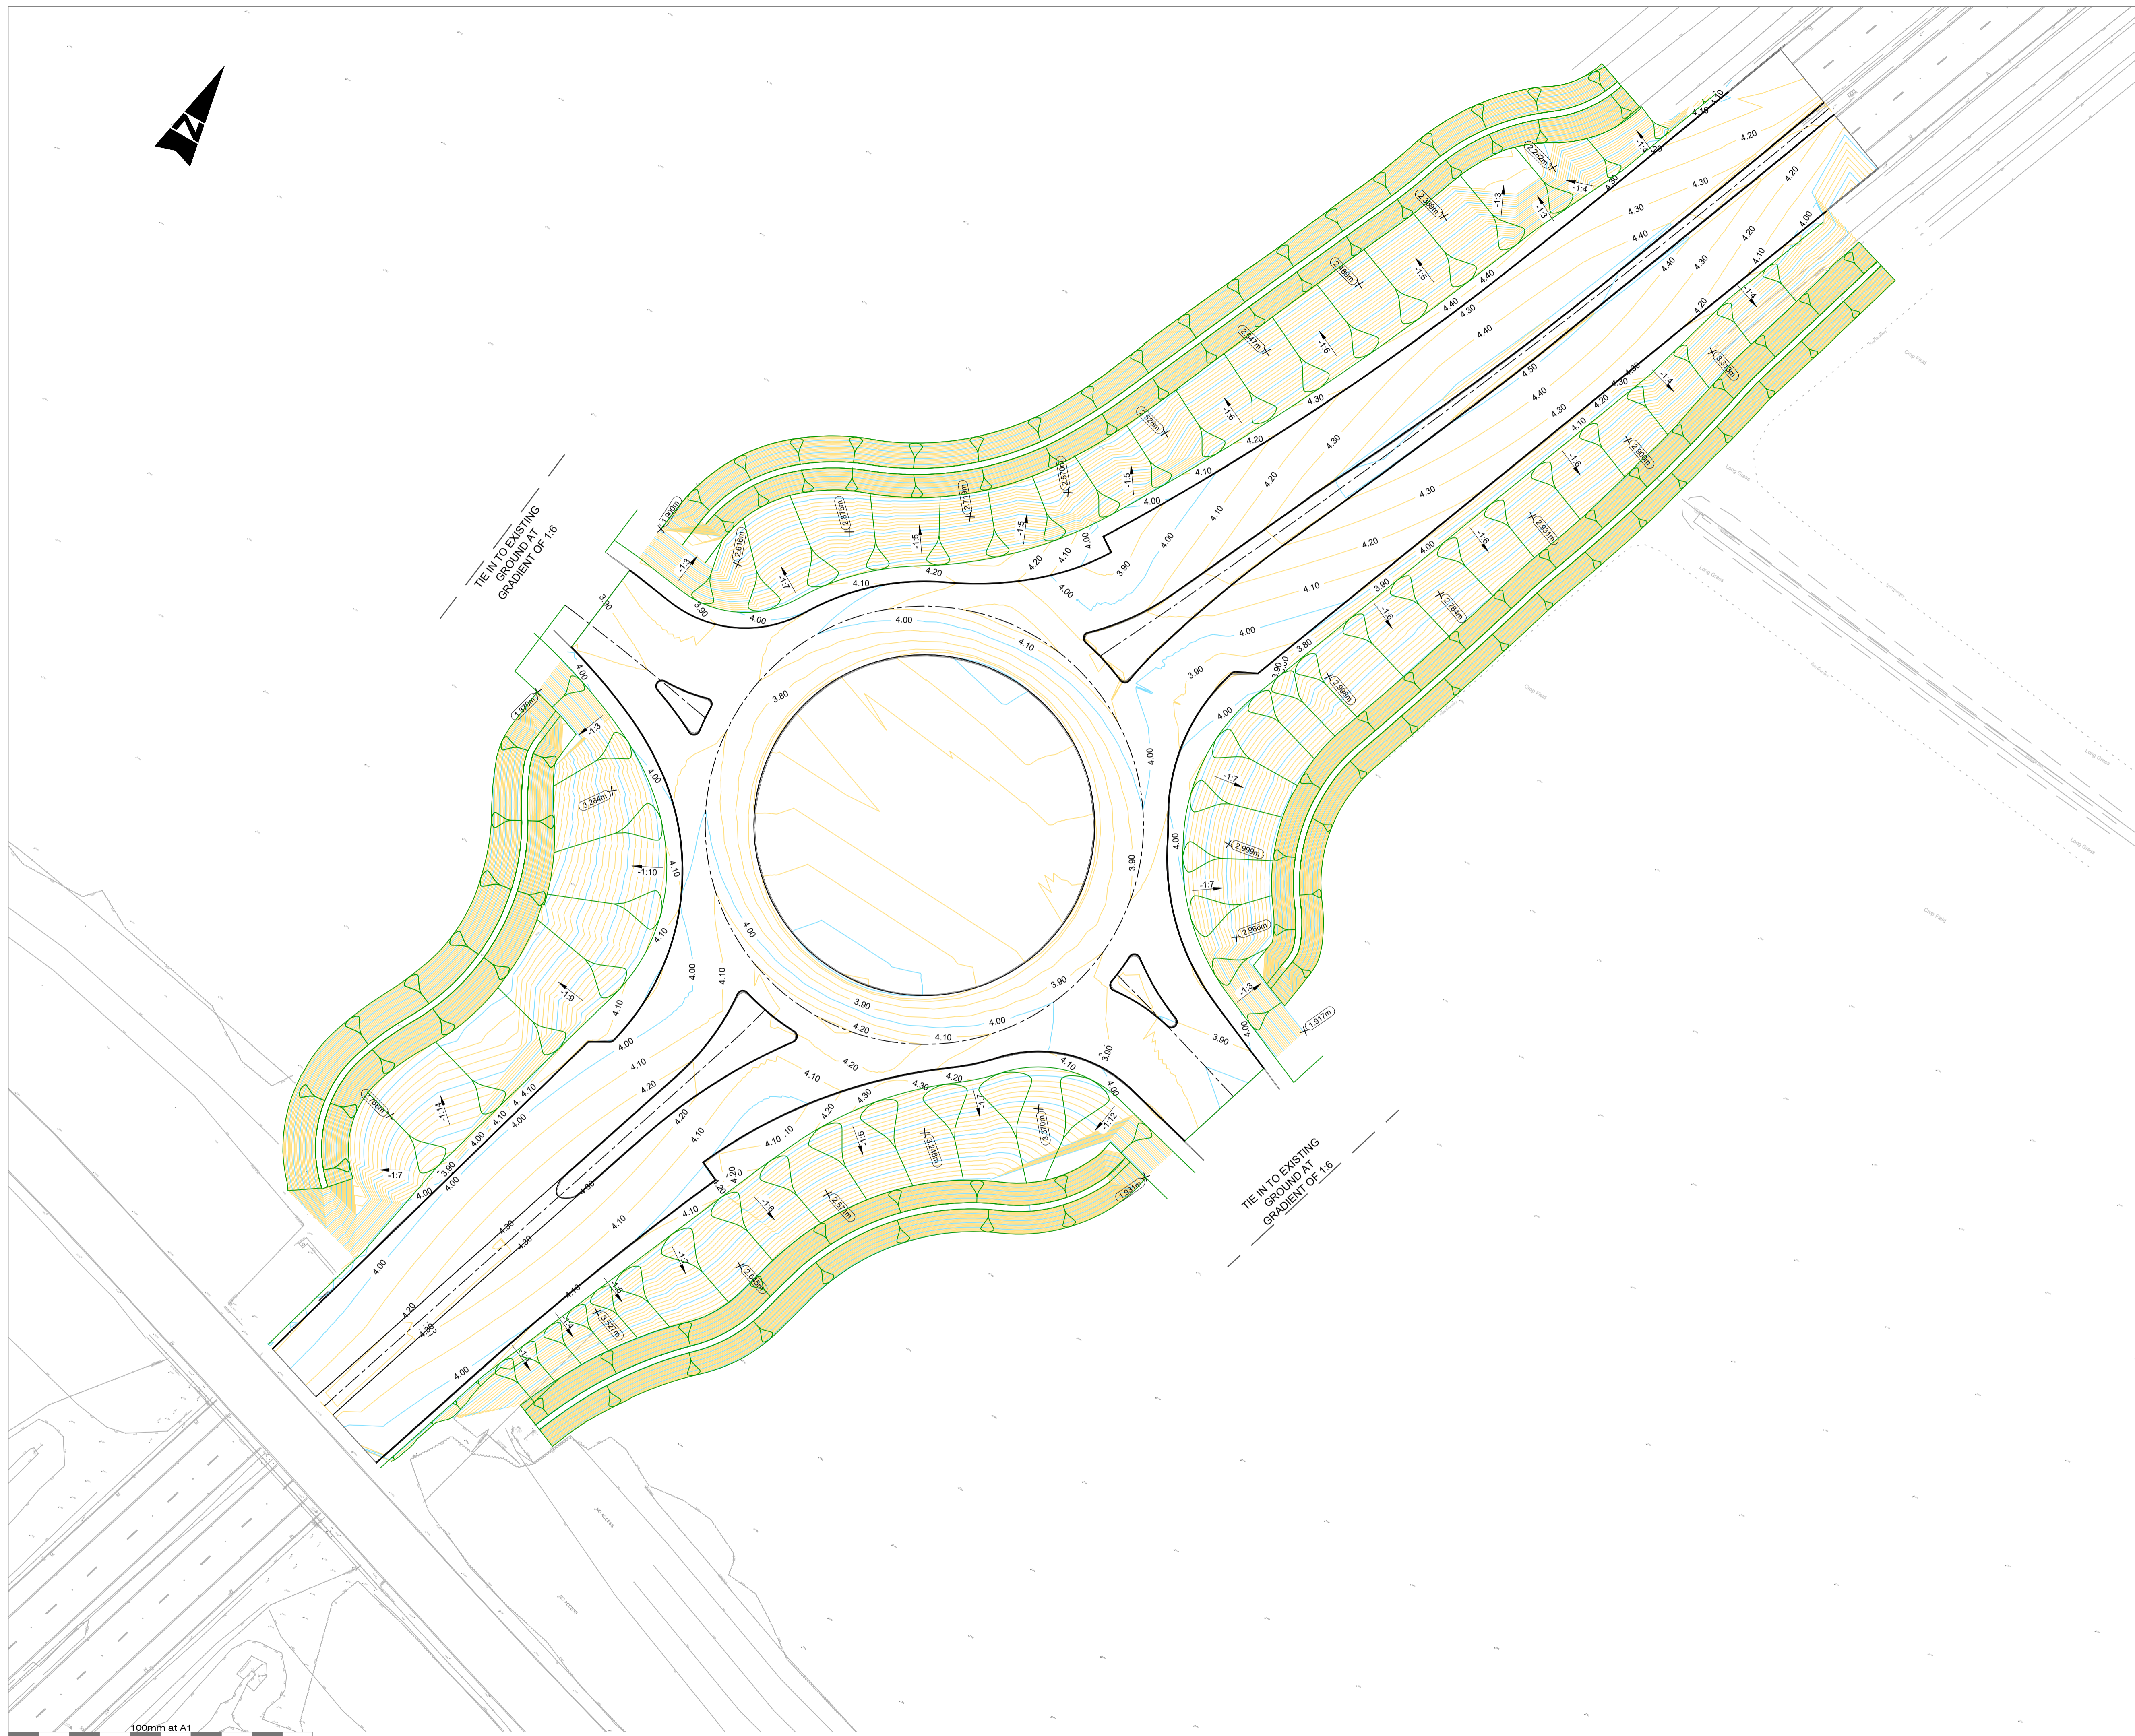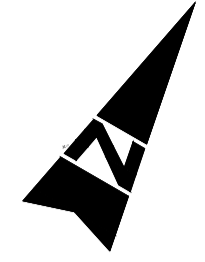


- NOTES:**
1. THESE NOTES ARE INTENDED TO AUGMENT DRAWINGS AND SPECIFICATIONS. WHERE CONFLICT OF REQUIREMENTS EXIST THE ORDER OF PRECEDENCE SHALL BE AS SHOWN IN THE SPECIFICATION, OTHERWISE THE STRICTEST PROVISION SHALL GOVERN.
  2. THIS DRAWING IS TO BE READ IN CONJUNCTION WITH ALL OTHER RELEVANT ENGINEERS AND ARCHITECTS DRAWINGS.
  3. DRAWINGS NOT TO BE SCALED. ALL DIMENSIONS TO BE CHECKED ON SITE BY THE CONTRACTOR. ANY DISCREPANCIES TO BE NOTIFIED TO THE ENGINEER AND FURTHER INSTRUCTIONS OBTAINED BEFORE WORK IS COMMENCED.
  4. PROPOSED CONTOURS ARE BASED ON THE FINAL KERB LINE AS-BUILT. THIS DRAWING IS FOR INFORMATION ONLY, REFER TO SETTING OUT DETAILS FOR LEVEL INFORMATION.

**AS-BUILT DRAWING**

THIS DRAWING IS ISSUED FOR INCLUSION IN THE PROJECT AS-BUILT DOCUMENTATION AND THE INFORMATION INDICATED IS, TO THE BEST OF OUR KNOWLEDGE, REPRESENTATIVE OF THE CONSTRUCTED WORKS.

PLEASE NOTE, ALAN WOOD & PARTNERS HAVE NOT CARRIED OUT ANY SITE SUPERVISION OF THE PROJECT DURING CONSTRUCTION. THE CONTRACTOR IS DEEMED TO HAVE INSTALLED THE WORKS IN ACCORDANCE WITH THE CONSTRUCTION ISSUE DRAWINGS, UNLESS NOTED OTHERWISE ON THIS DRAWING OR CONFIRMED SEPARATELY BY THE CONTRACTOR IN WRITING. ALAN WOOD & PARTNERS ACCEPT NO LIABILITY FOR DEVIATIONS BETWEEN THESE DRAWINGS AND THE CONSTRUCTED WORKS, THE RESPONSIBILITY FOR WHICH LIES WHOLLY WITH THE CONTRACTOR.


|                         |          |     |     |     |
|-------------------------|----------|-----|-----|-----|
| C02 CONSTRUCTION RECORD | 28.08.25 | FM  | JEK | BH  |
| C01 FOR CONSTRUCTION    | 20.05.24 | GDV | BH  | BH  |
| Rev Description         | Date     | By  | Chk | App |

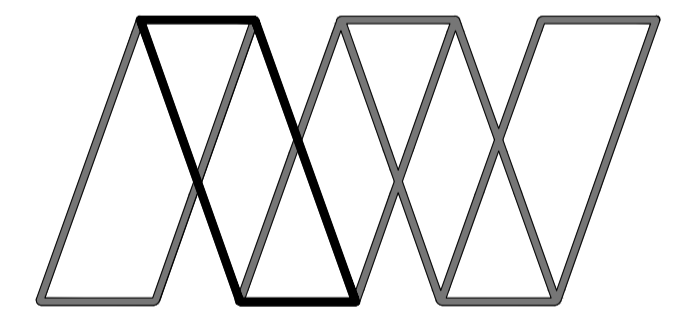


**Alan Wood & Partners**

|  |   |
|--|---|
| <p>York Office<br/>Omega 2<br/>Monks Cross Drive<br/>York<br/>YO32 9GZ</p> <p>T. 01904 611594<br/>www.alanwood.co.uk</p> | <p>Consulting Civil<br/>&amp; Structural Engineers<br/>Project Managers<br/>Building Surveyors</p> <p>Hull T. 01482 442138<br/>Lincoln T. 01522 300210<br/>London T. 02071 860761<br/>Scarborough T. 01723 865484<br/>Sheffield T. 01142 440077<br/>Leeds T. 01135 311098</p> |
|--|---|

|  |                                       |            |       |      |     |
|--|---------------------------------------|------------|-------|------|-----|
| Project:   | M181/B1450 BURRINGHAM ROAD ROUNDABOUT |            |       |      |     |
| Client:  | North Lincolnshire Council            |            |       |      |     |
| Drawing:   | PROPOSED CONTOUR PLAN - SHEET 1       |            |       |      |     |
| Role:  | CIVIL ENGINEER                        |            |       |      |     |
| Drawing Status:                                  | CONSTRUCTION RECORD                   |            |       |      |     |
| Job. no.   | 47603                                 | Scale@ A1: | 1:500 | Rev. | C02 |
| Project Originator Volume Level Type Role Number |                                       |            |       |      |     |
| M181 - AWP - 01 - 01 - DR - D - 0251             |                                       |            |       |      |     |

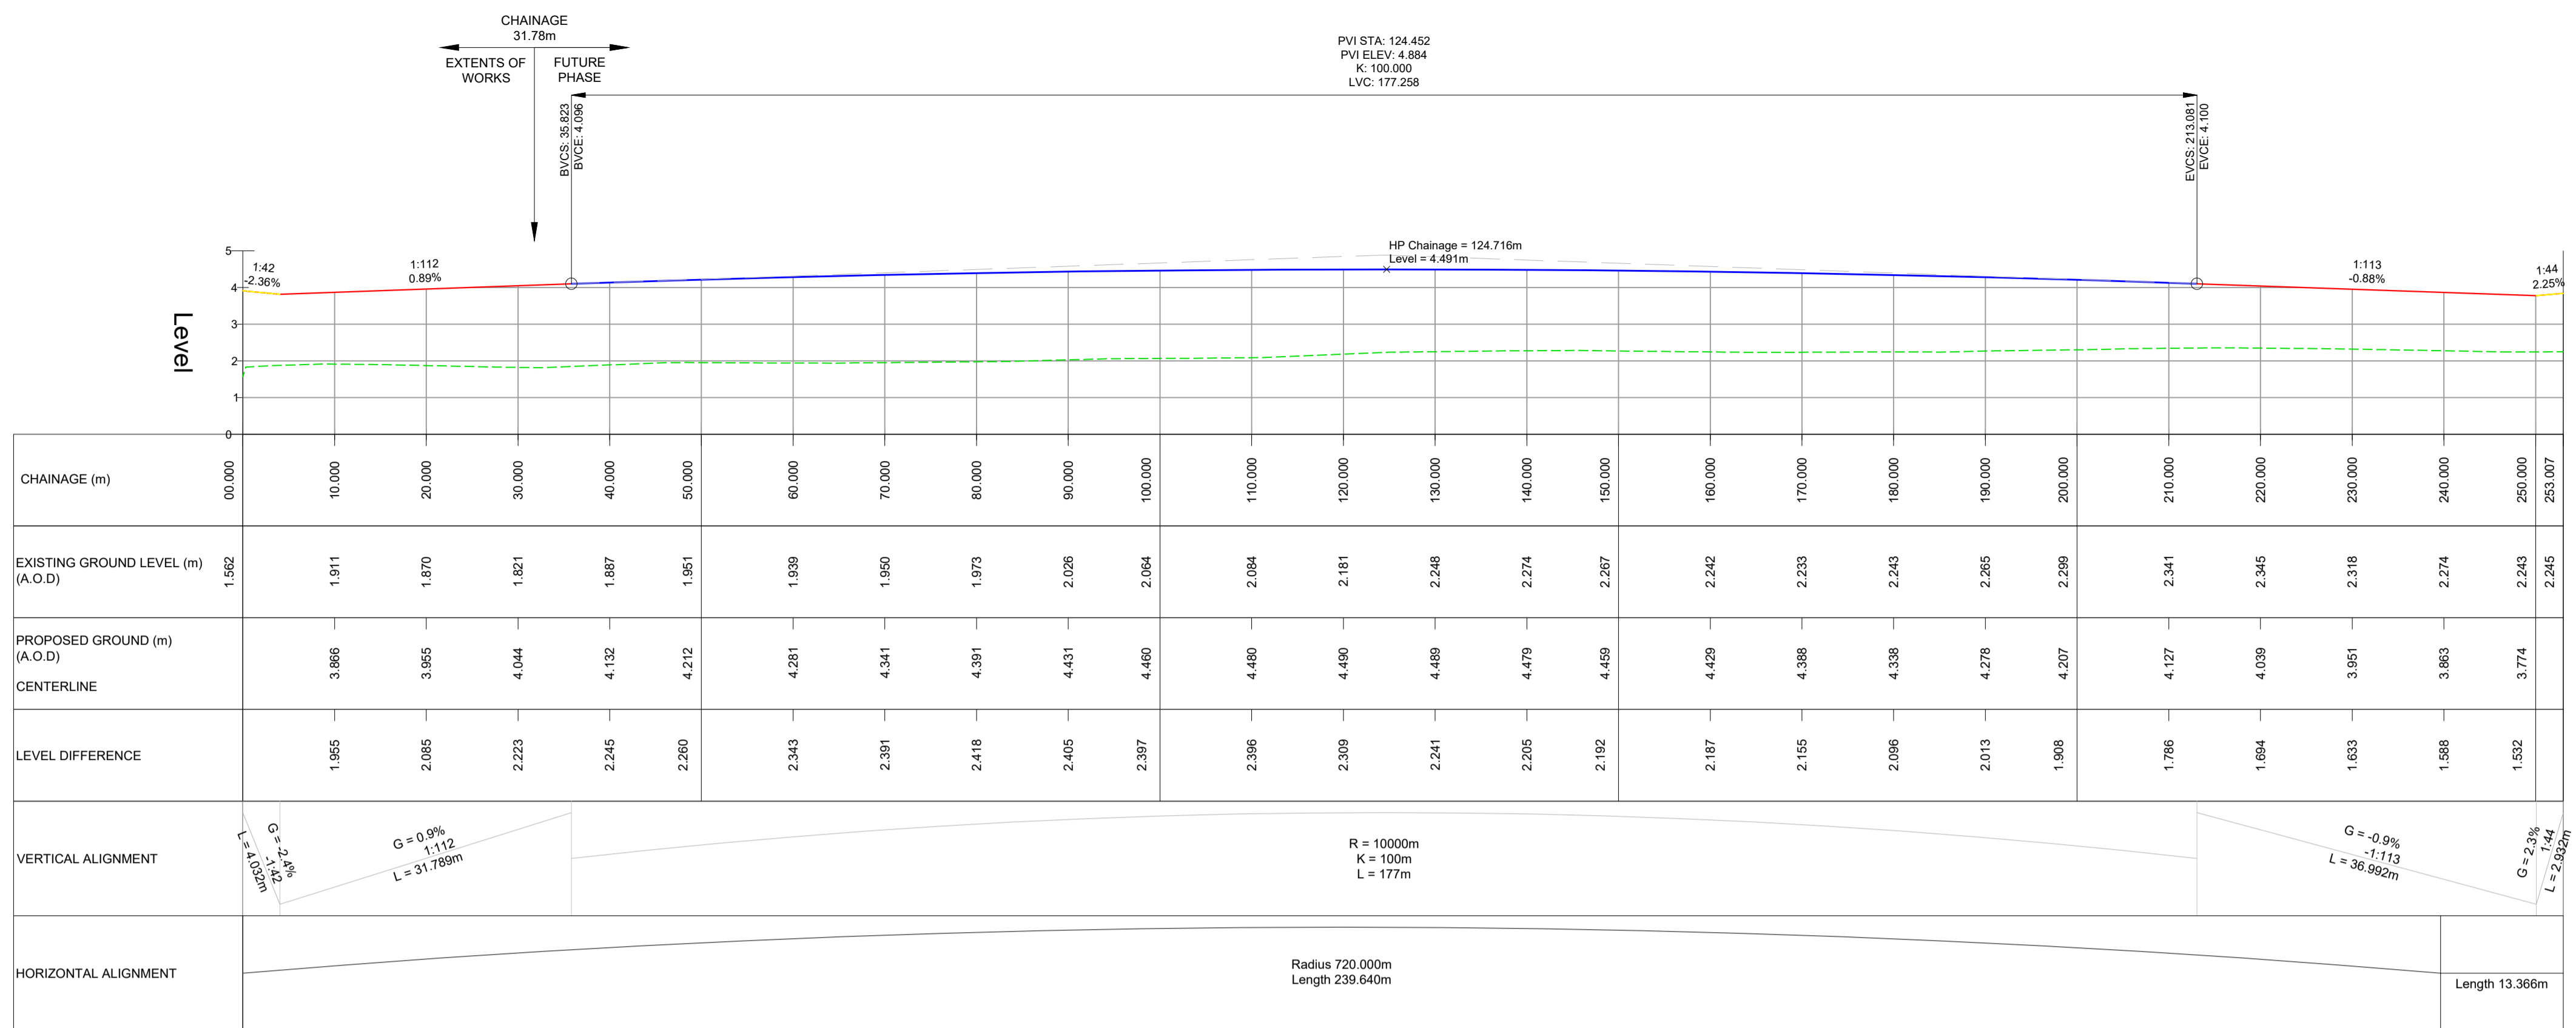

E Roundabout - CL - W Arm  
 SCALE: H 1:500, V 1:125.  
 CH.0.000m - CH.253.007m

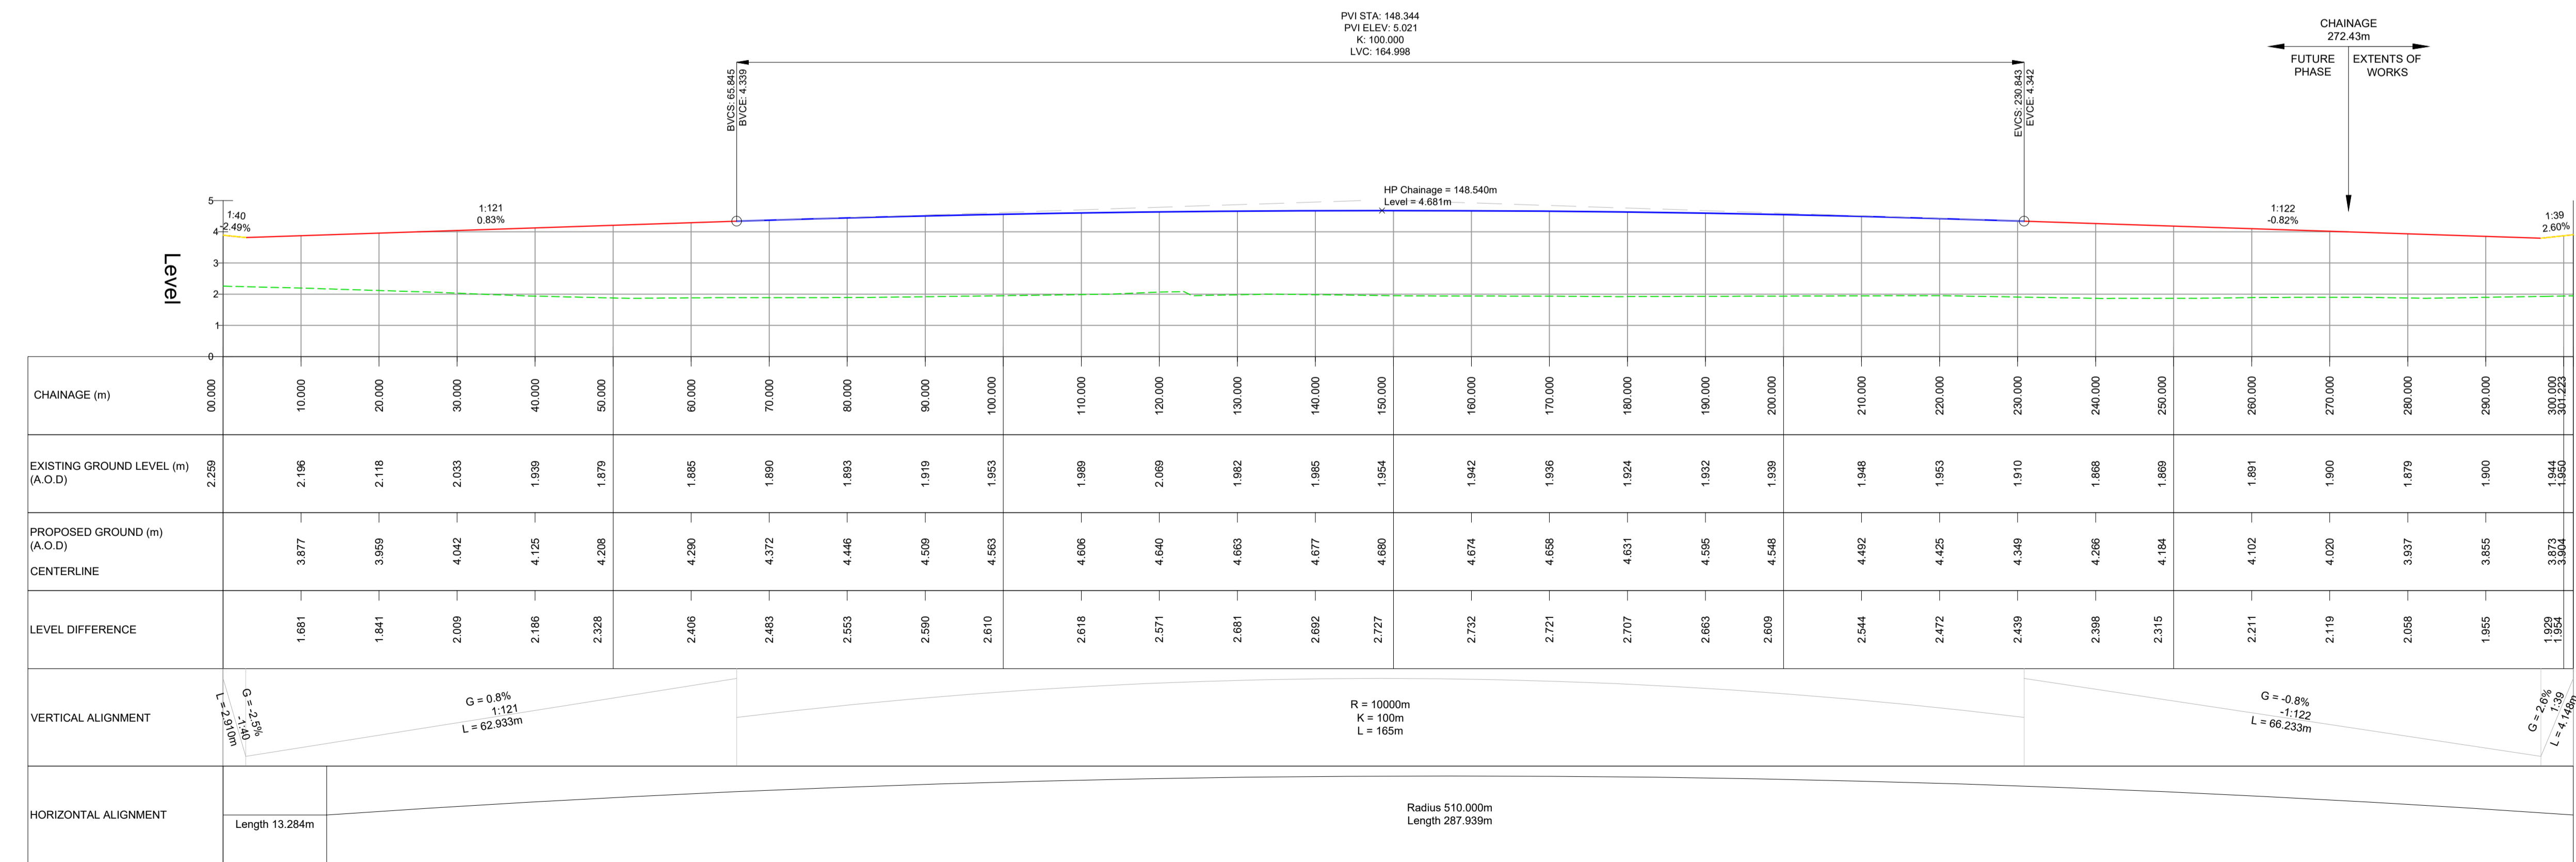


W Roundabout - CL - E Arm  
 SCALE: H 1:500, V 1:125.  
 CH.0.000m - CH.301.223m

**AS-BUILT DRAWING**

THIS DRAWING IS ISSUED FOR INCLUSION IN THE PROJECT AS-BUILT DOCUMENTATION AND THE INFORMATION INDICATED IS, TO THE BEST OF OUR KNOWLEDGE, REPRESENTATIVE OF THE CONSTRUCTED WORKS.

PLEASE NOTE, ALAN WOOD & PARTNERS HAVE NOT CARRIED OUT ANY SITE SUPERVISION OF THE PROJECT DURING CONSTRUCTION. THE CONTRACTOR IS DEEMED TO HAVE INSTALLED THE WORKS IN ACCORDANCE WITH THE CONSTRUCTION ISSUE DRAWINGS, UNLESS NOTED OTHERWISE ON THIS DRAWING OR CONFIRMED SEPARATELY BY THE CONTRACTOR IN WRITING. ALAN WOOD & PARTNERS ACCEPT NO LIABILITY FOR DEVIATIONS BETWEEN THESE DRAWINGS AND THE CONSTRUCTED WORKS. THE RESPONSIBILITY FOR WHICH LIES WHOLLY WITH THE CONTRACTOR.

|                               |             |      |     |     |     |
|-------------------------------|-------------|------|-----|-----|-----|
| C02 CONSTRUCTION RECORD ISSUE | 29.08.25    | FM   | JEK | BH  |     |
| C01 FOR CONSTRUCTION          | 20.05.24    | GDV  | BH  | BH  |     |
| Rev                           | Description | Date | By  | Chk | App |

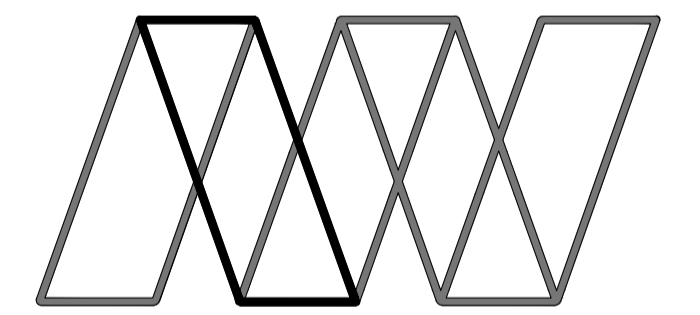

**Alan Wood & Partners**


|  |  |
|--|--|
| York Office<br>Omega 2<br>Monks Cross Drive<br>York<br>YO32 9GZ<br><br>T. 01904 611594<br>www.alanwood.co.uk | <b>Consulting Civil &amp; Structural Engineers</b><br><b>Project Managers</b><br><b>Building Surveyors</b><br><br>Hull<br>Lincoln<br>London<br>Scarborough<br>Sheffield<br>Leeds<br><br>T. 01482 442138<br>T. 01522 300210<br>T. 02071 860761<br>T. 01723 865484<br>T. 01142 440077<br>T. 01135 311098 |
|--|--|

|  |                                       |            |       |      |     |
|--|---------------------------------------|------------|-------|------|-----|
| Project:   | M181/B1450 BURRINGHAM ROAD ROUNDABOUT |            |       |      |     |
| Client:  |                                       |            |       |      |     |
| Drawing:   | LONG SECTION - SHEET 1                |            |       |      |     |
| Role:  | CIVIL ENGINEER                        |            |       |      |     |
| Drawing Status:                                  | CONSTRUCTION RECORD                   |            |       |      |     |
| Job. no.   | 47603                                 | Scale@ A1: | 1:500 | Rev. | C02 |
| Project Originator Volume Level Type Role Number |                                       |            |       |      |     |
| M181 - AWP - 01 - 01 - DR - D - 0301             |                                       |            |       |      |     |


**AS-BUILT DRAWING**

THIS DRAWING IS ISSUED FOR INCLUSION IN THE PROJECT AS-BUILT DOCUMENTATION AND THE INFORMATION INDICATED IS, TO THE BEST OF OUR KNOWLEDGE, REPRESENTATIVE OF THE CONSTRUCTED WORKS.

PLEASE NOTE: ALAN WOOD & PARTNERS HAVE NOT CARRIED OUT ANY SITE SUPERVISION OF THE PROJECT DURING CONSTRUCTION. THE CONTRACTOR IS DEEMED TO HAVE INSTALLED THE WORKS IN ACCORDANCE WITH THE CONSTRUCTION ISSUE DRAWINGS, UNLESS NOTED OTHERWISE ON THIS DRAWING OR CONFIRMED SEPARATELY BY THE CONTRACTOR IN WRITING. ALAN WOOD & PARTNERS ACCEPT NO LIABILITY FOR DEVIATIONS BETWEEN THESE DRAWINGS AND THE CONSTRUCTED WORKS. THE RESPONSIBILITY FOR WHICH LIES WHOLLY WITH THE CONTRACTOR.

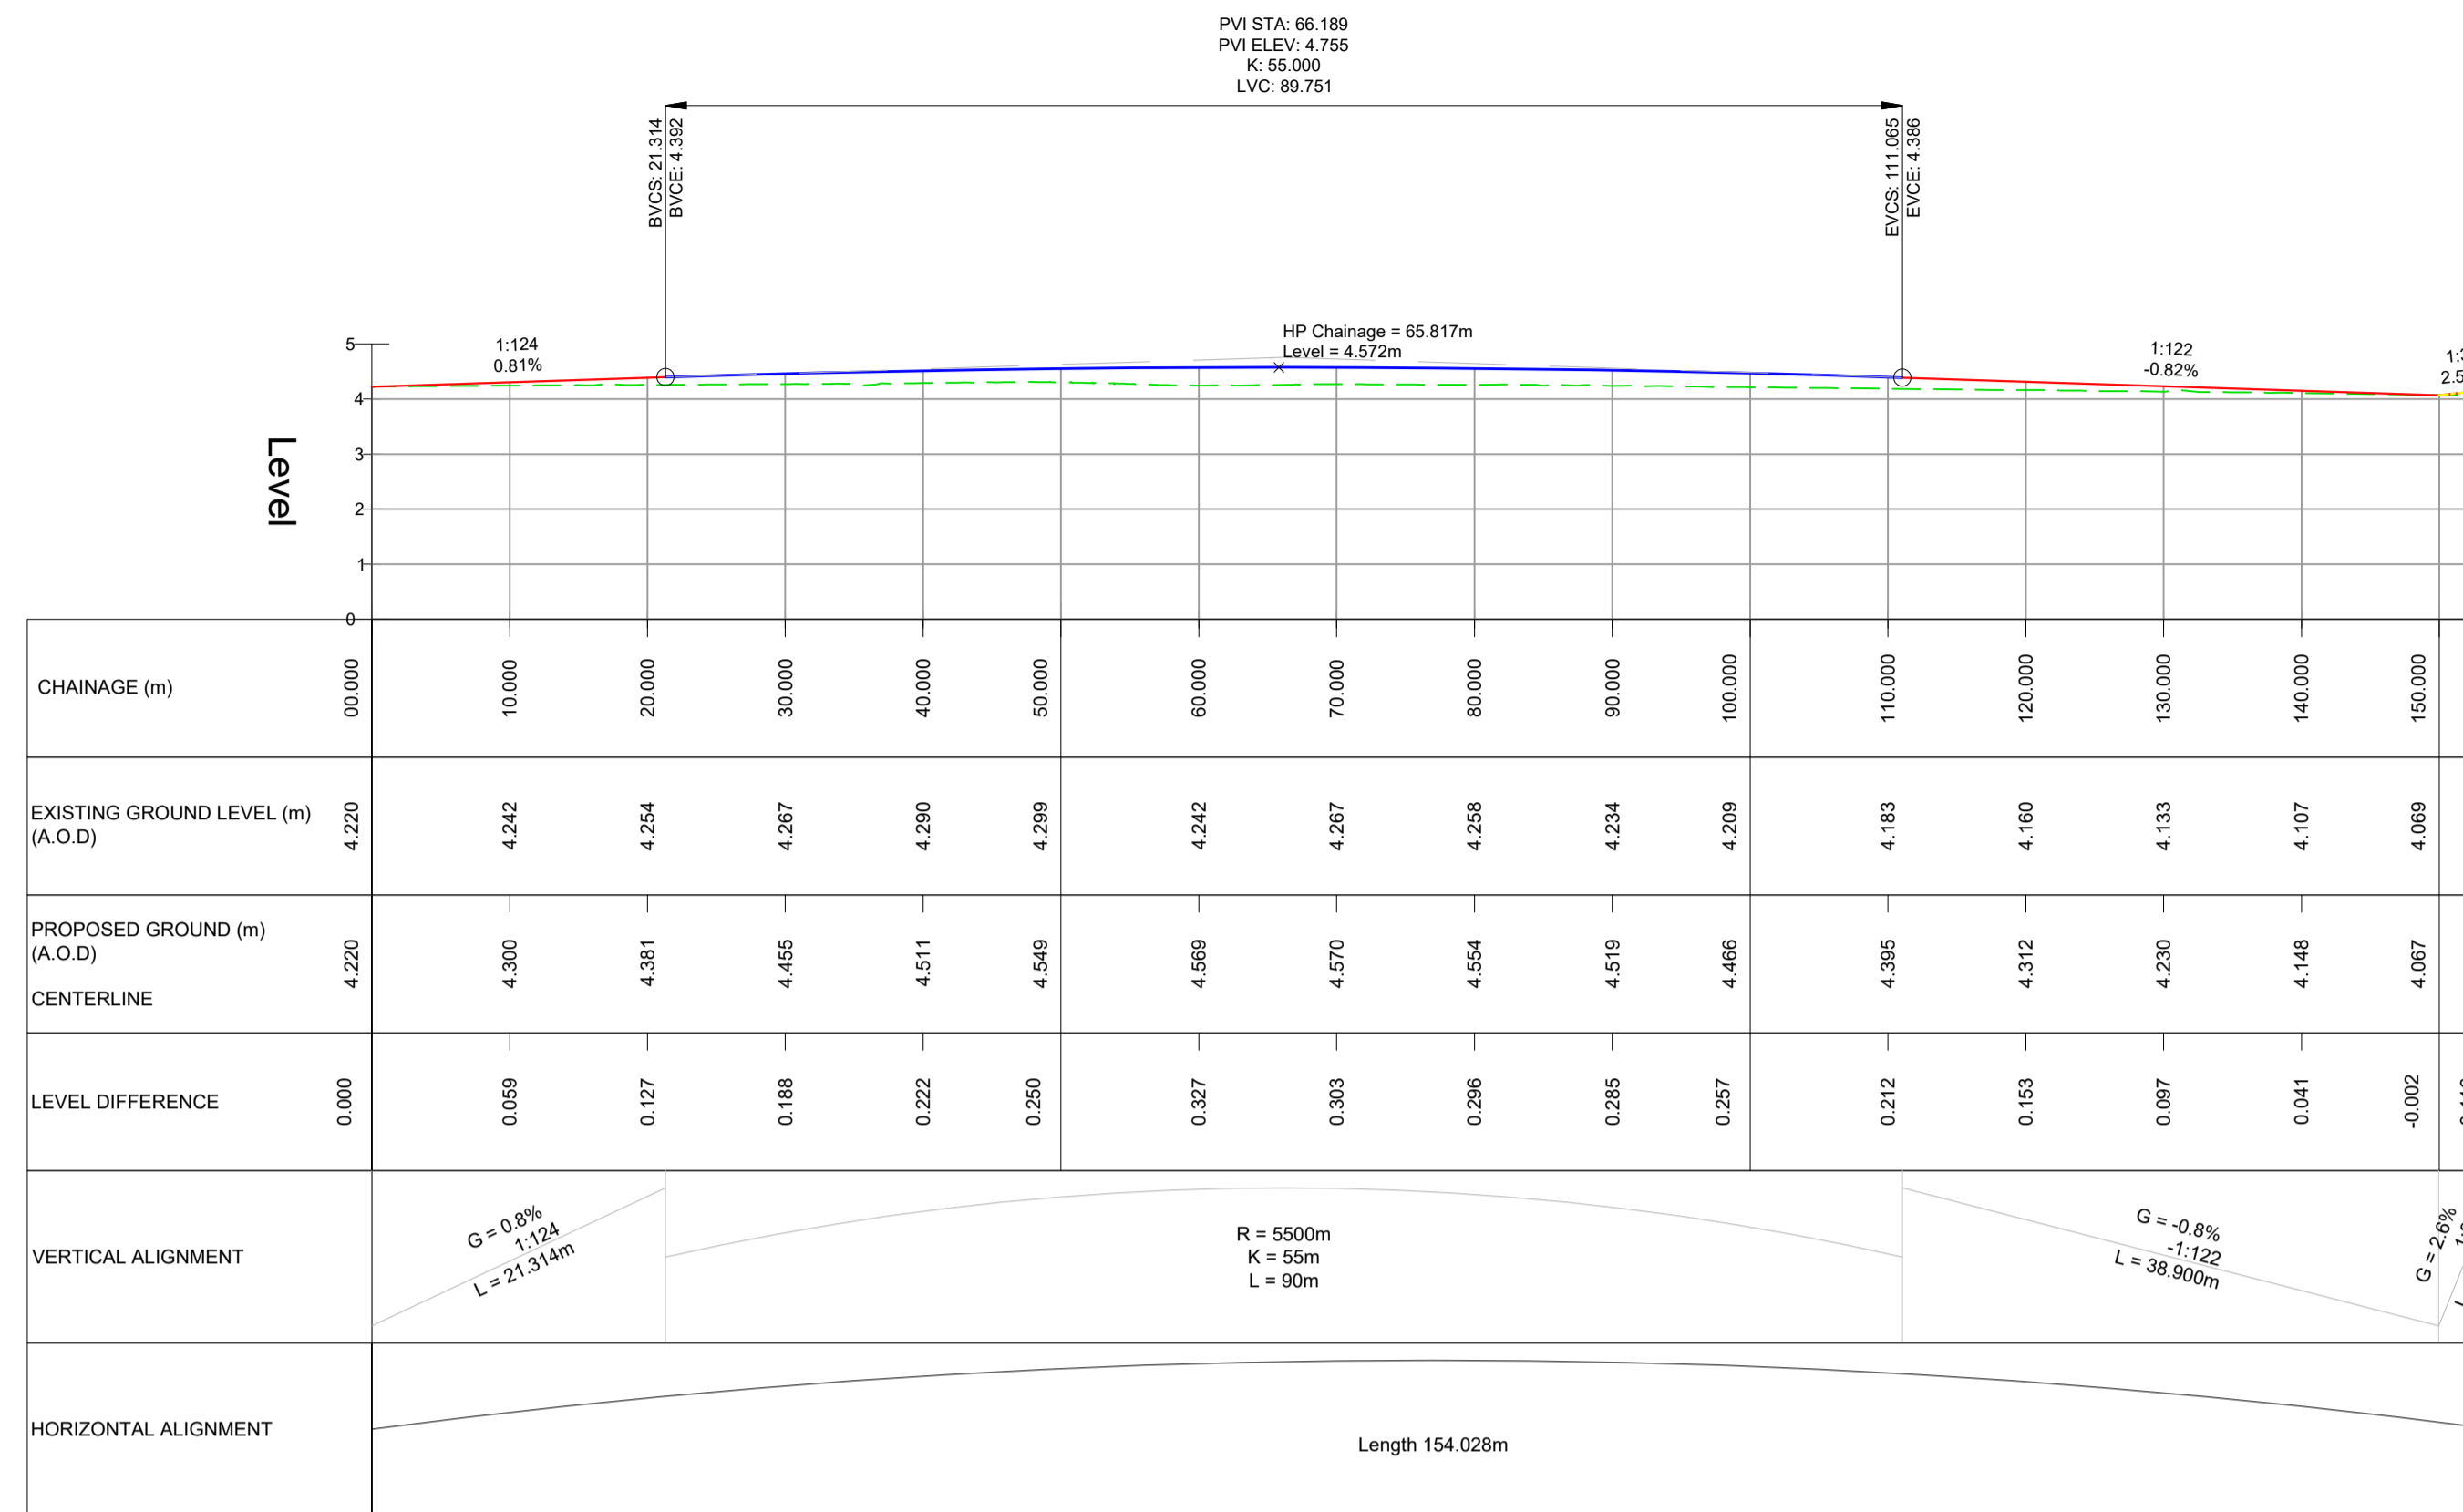


C Roundabout - CL - N Arm  
SCALE: H 1:500, V 1:125.  
CH.0.000m - CH.154.028m

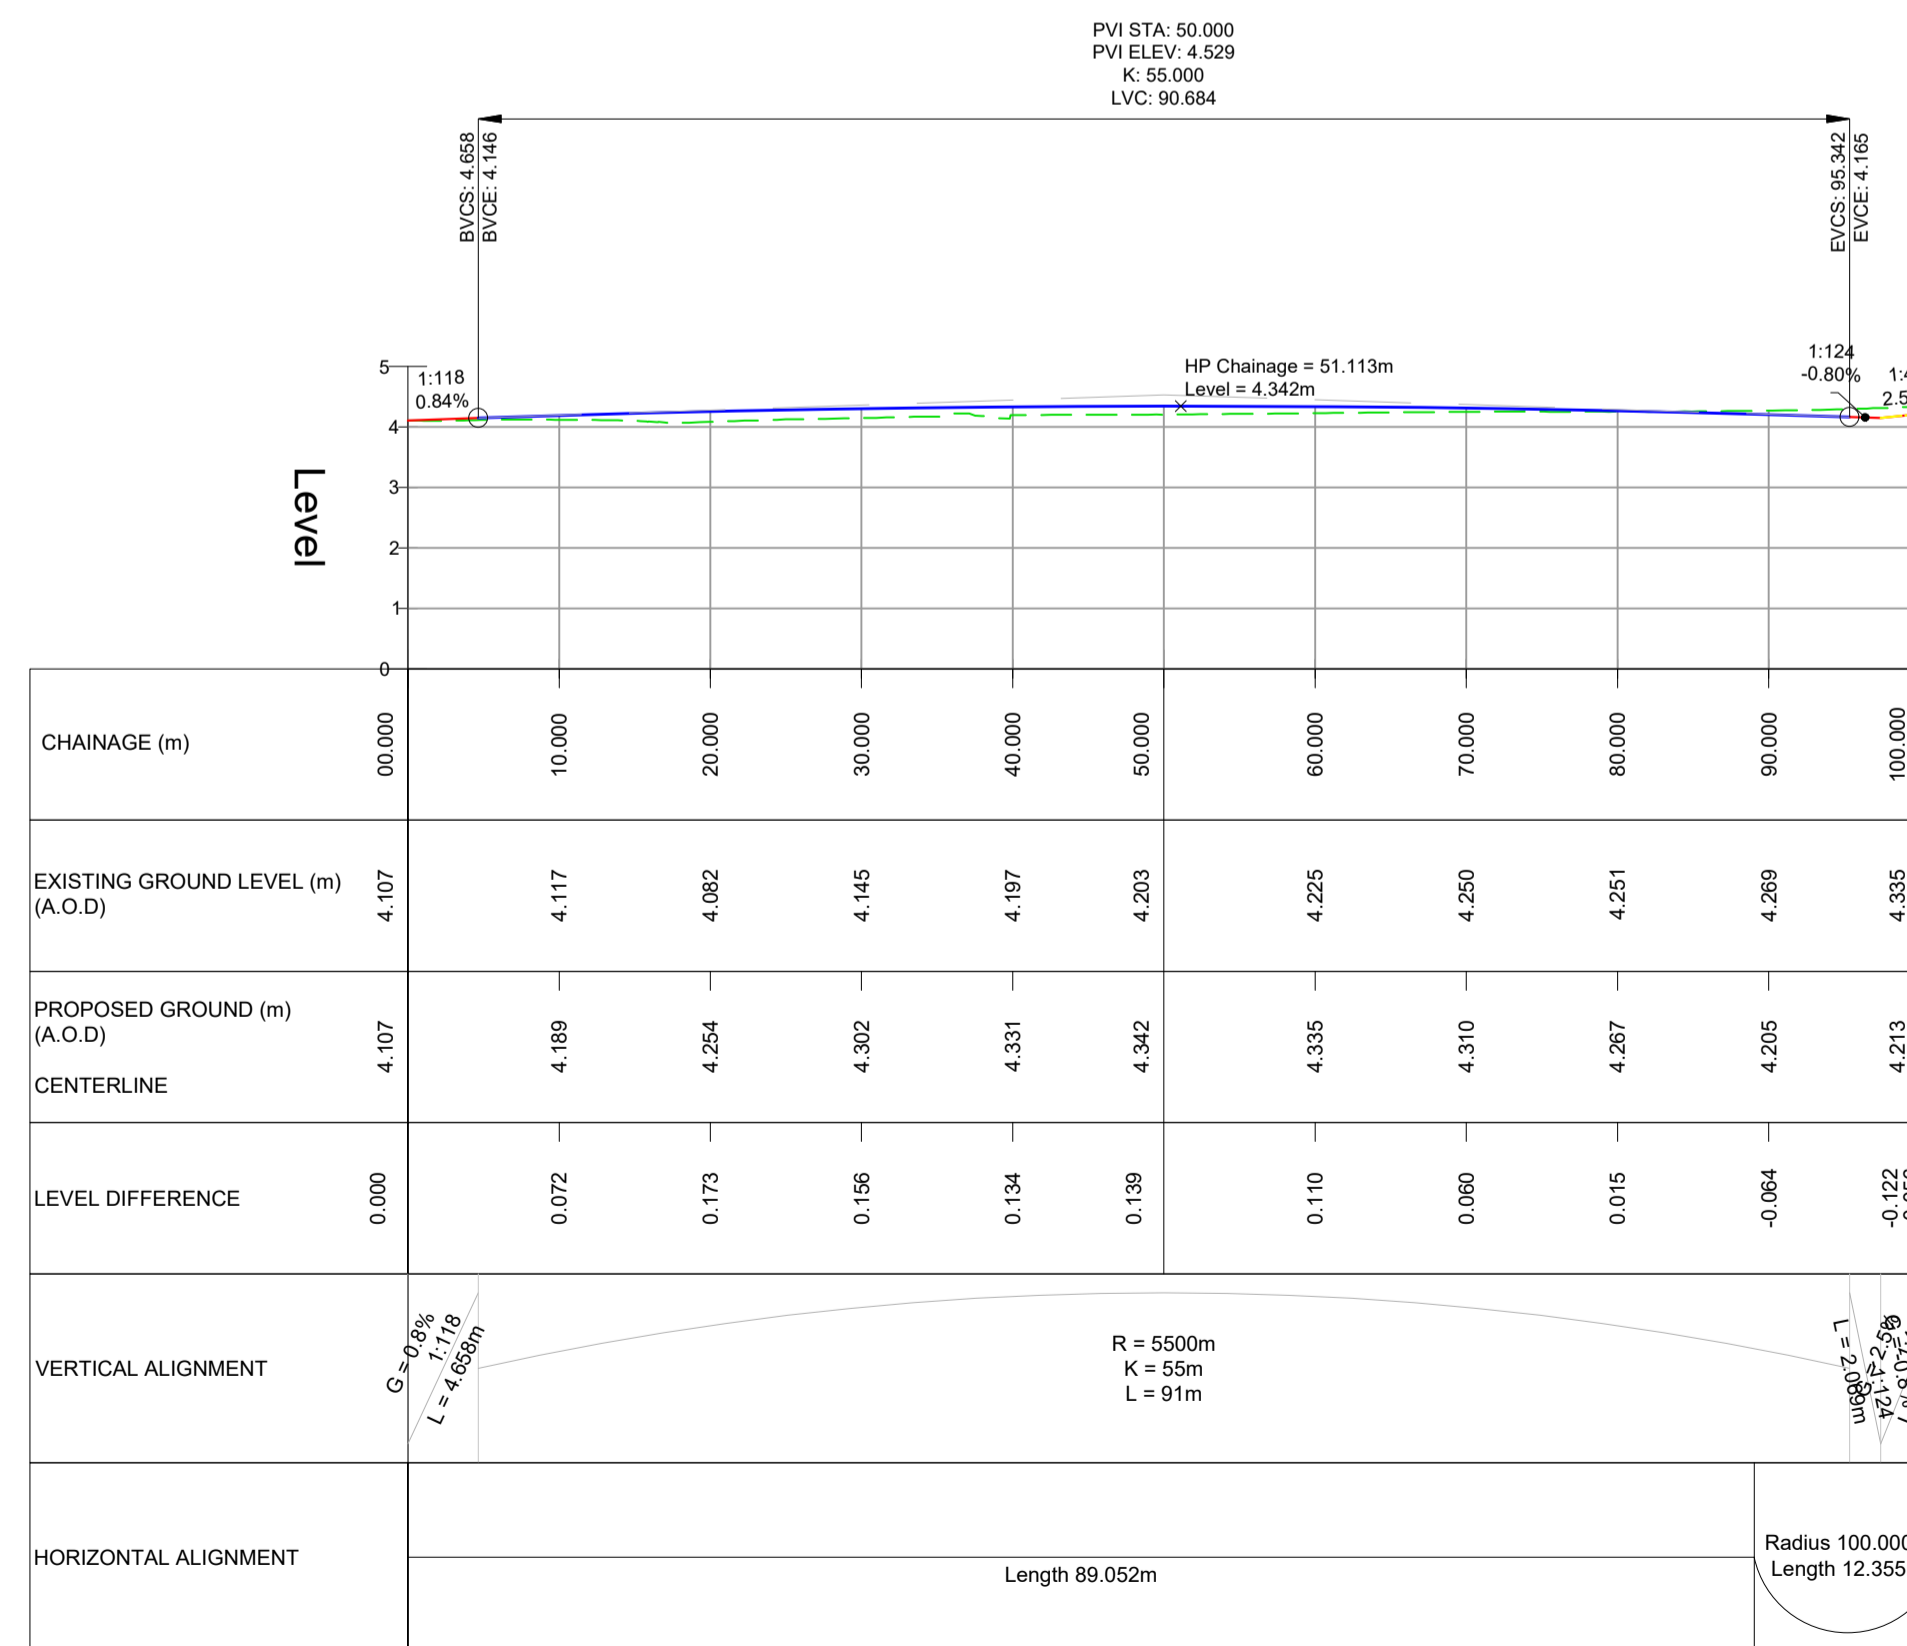

C Roundabout - CL - S Arm  
SCALE: H 1:500, V 1:125.  
CH.0.000m - CH.101.407m


|     |                           |          |     |     |     |
|-----|---------------------------|----------|-----|-----|-----|
| C02 | CONSTRUCTION RECORD ISSUE | 29.08.25 | FM  | JEK | BH  |
| C01 | FOR CONSTRUCTION          | 20.05.24 | GDV | BH  | BH  |
| Rev | Description               | Date     | By  | Chk | App |

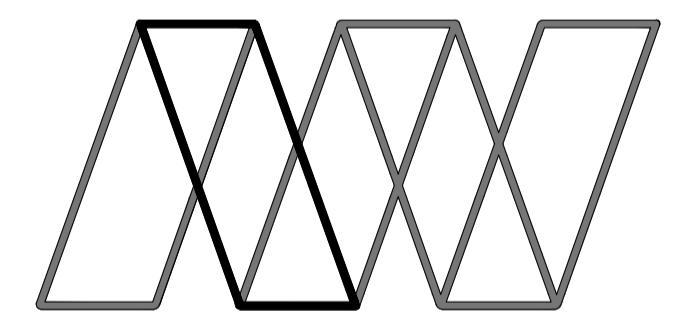


**Alan Wood & Partners**

|  |  |
|--|--|
| York Office<br>Omega 2<br>Monks Cross Drive<br>York<br>YO32 9GZ<br><br>T. 01904 611594<br>www.alanwood.co.uk | Consulting Civil<br>& Structural Engineers<br>Project Managers<br>Building Surveyors<br><br>Hull<br>Lincoln<br>London<br>Scarborough<br>Sheffield<br>Leeds<br><br>T. 01482 442138<br>T. 01522 300210<br>T. 02071 860761<br>T. 01723 865484<br>T. 01142 440077<br>T. 01135 311098 |
|--|--|


|                 |                                       |                  |          |      |      |        |
|-----------------|---------------------------------------|------------------|----------|------|------|--------|
| Project:        | M181/B1450 BURRINGHAM ROAD ROUNDABOUT |                  |          |      |      |        |
| Client:         | North Lincolnshire Council            |                  |          |      |      |        |
| Drawing:        | LONG SECTION - SHEET 2                |                  |          |      |      |        |
| Role:           | CIVIL ENGINEER                        |                  |          |      |      |        |
| Drawing Status: | CONSTRUCTION RECORD                   |                  |          |      |      |        |
| Job. no.        | 47603                                 | Scale@ A1: 1:500 | Rev. C02 |      |      |        |
| Project         | Originator                            | Volume           | Level    | Type | Role | Number |
| M181 - AWP - 01 | - 01                                  | - DR - D         | - 0302   |      |      |        |

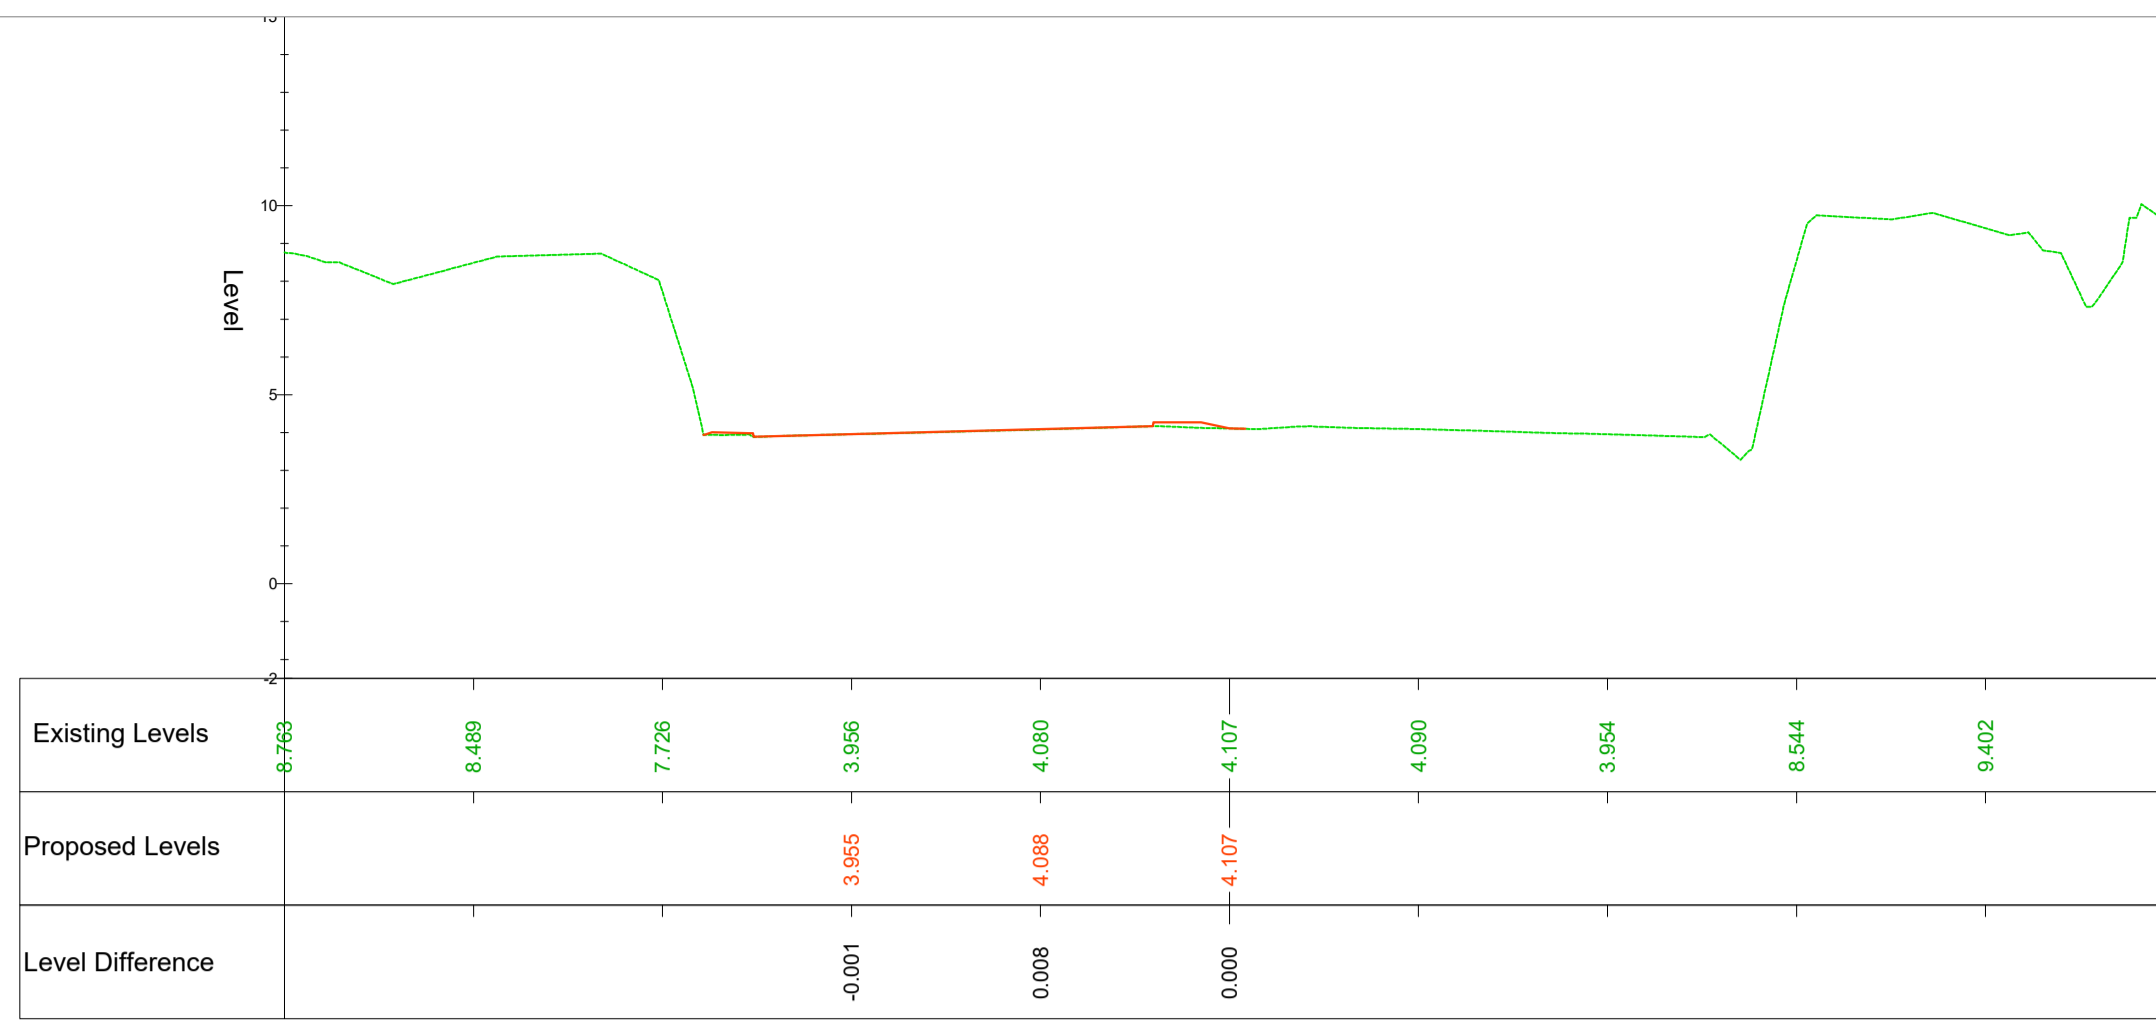


C Roundabout - CL - S Arm - Ch.0.00m

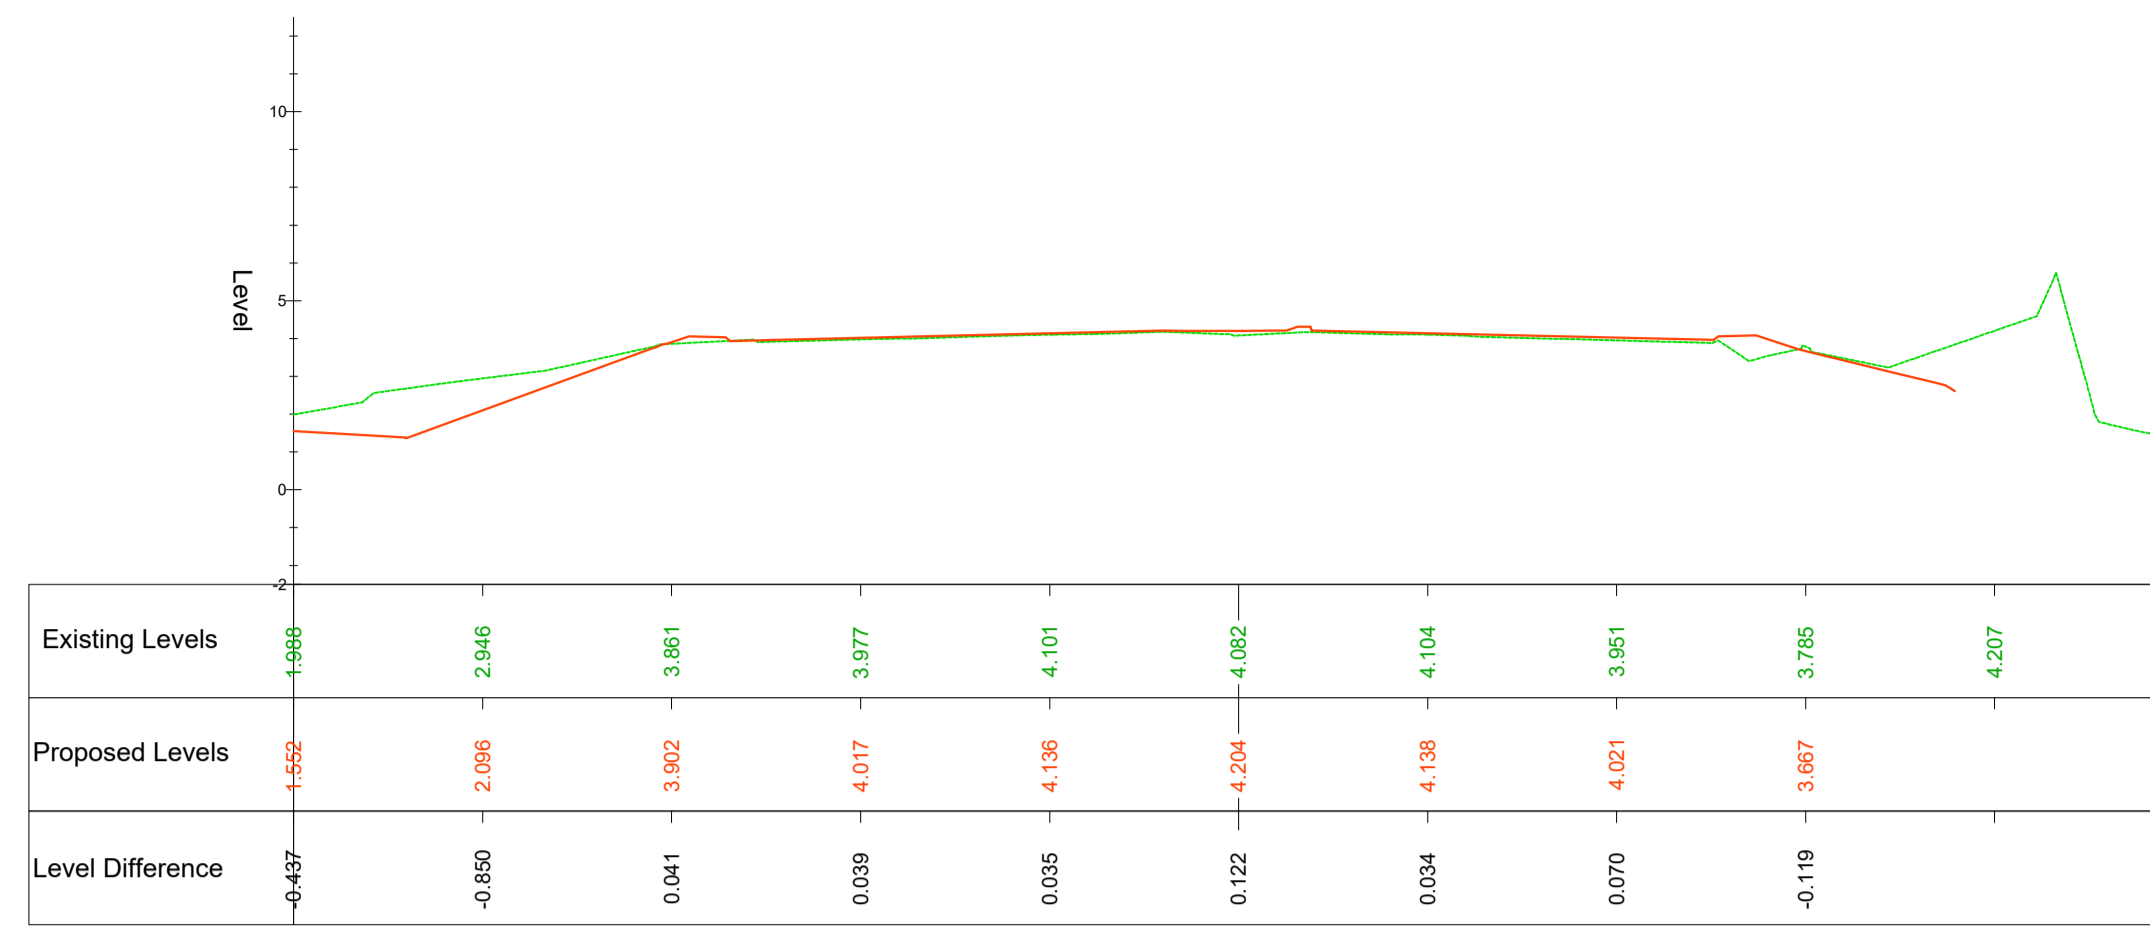


C Roundabout - CL - S Arm - Ch.20.00m

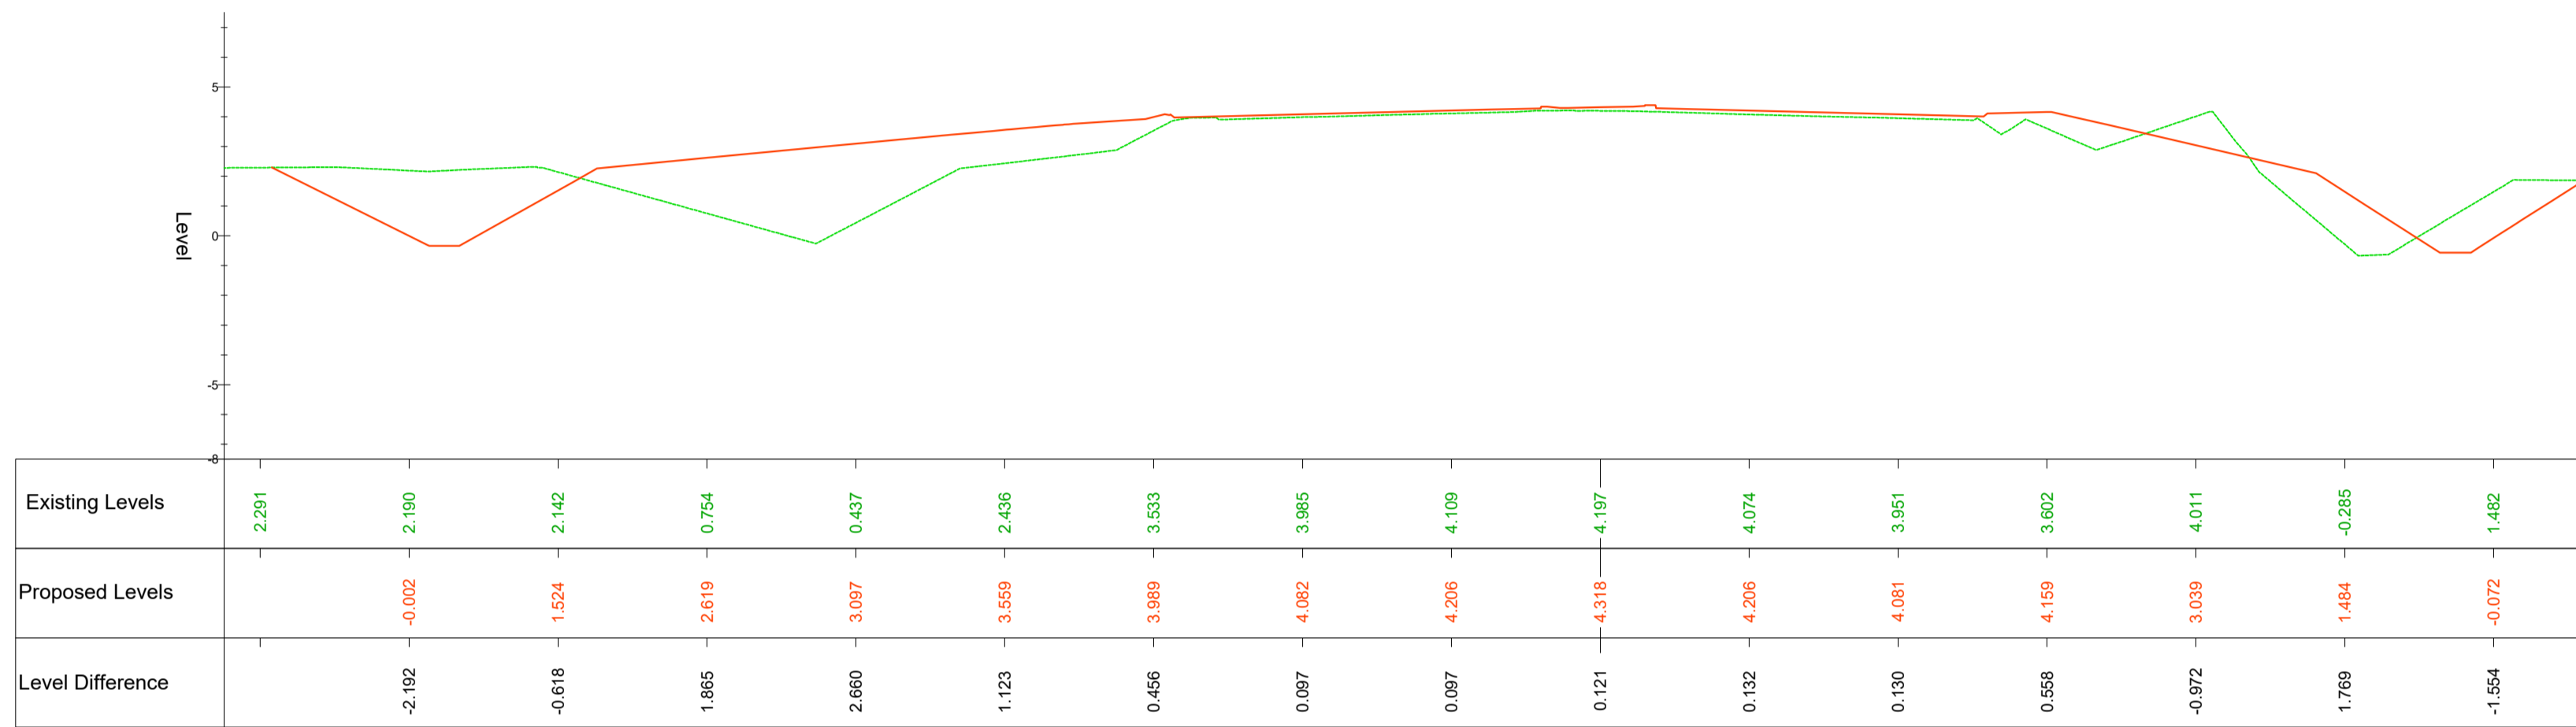

C Roundabout - CL - S Arm - Ch.40.00m

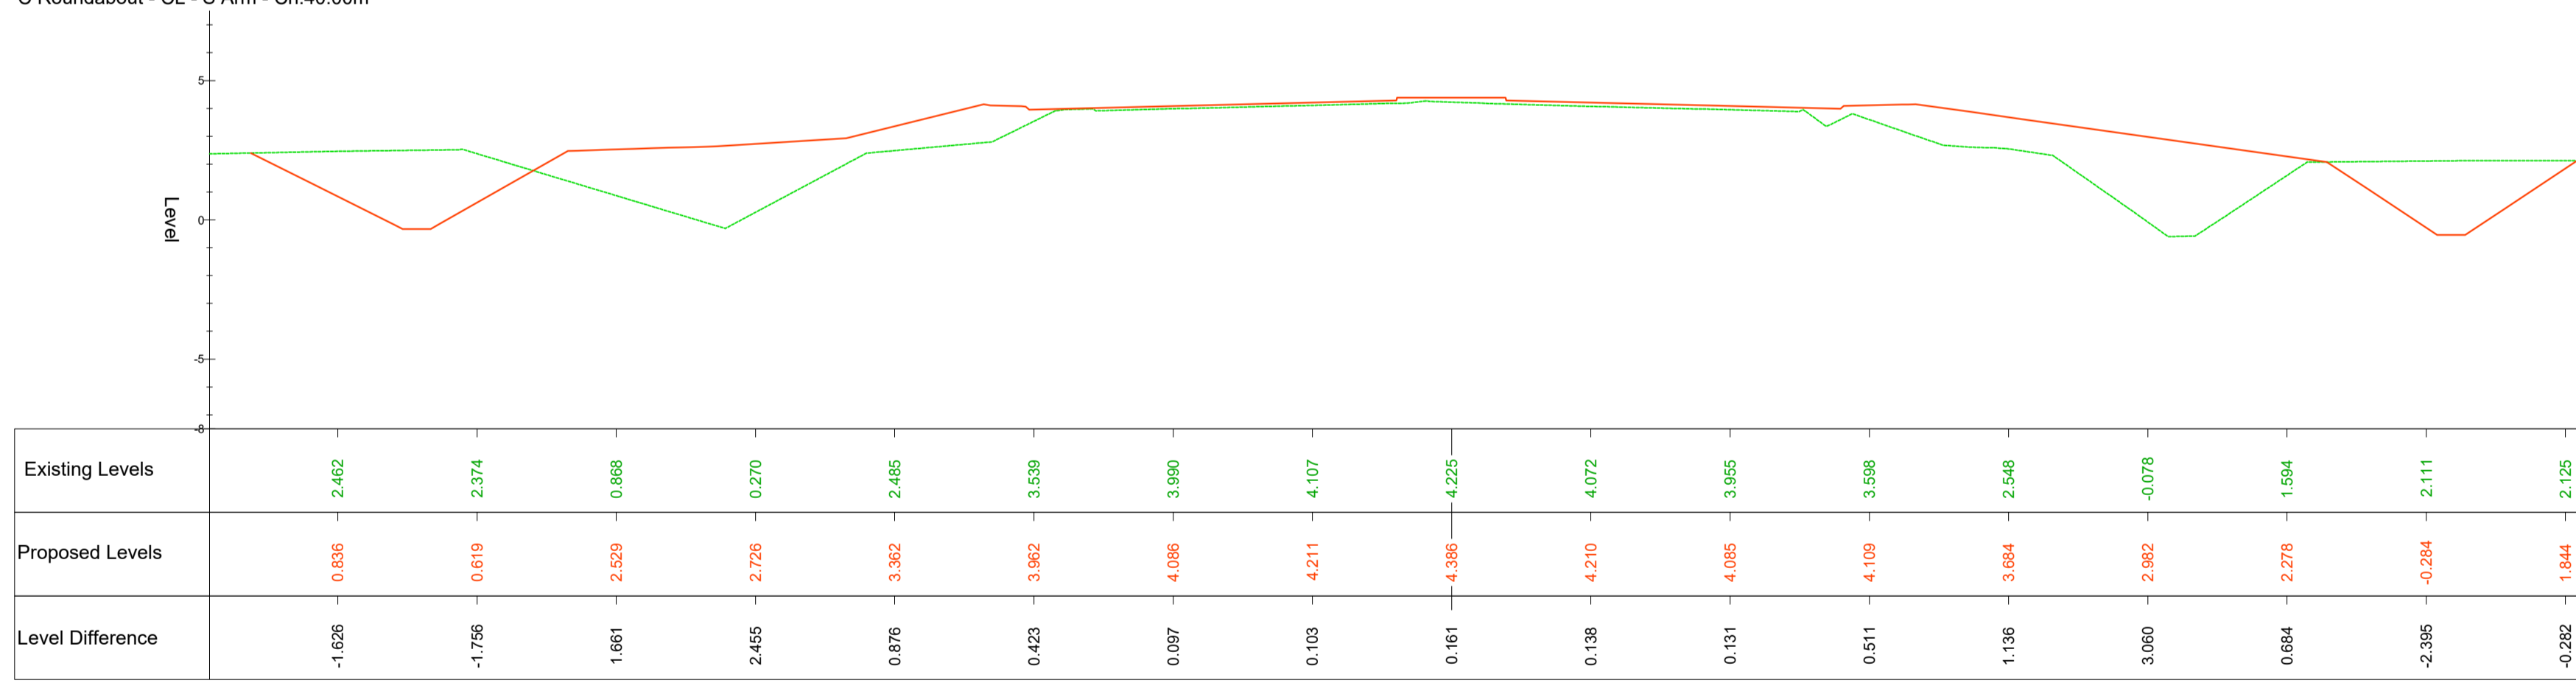

C Roundabout - CL - S Arm - Ch.60.00m

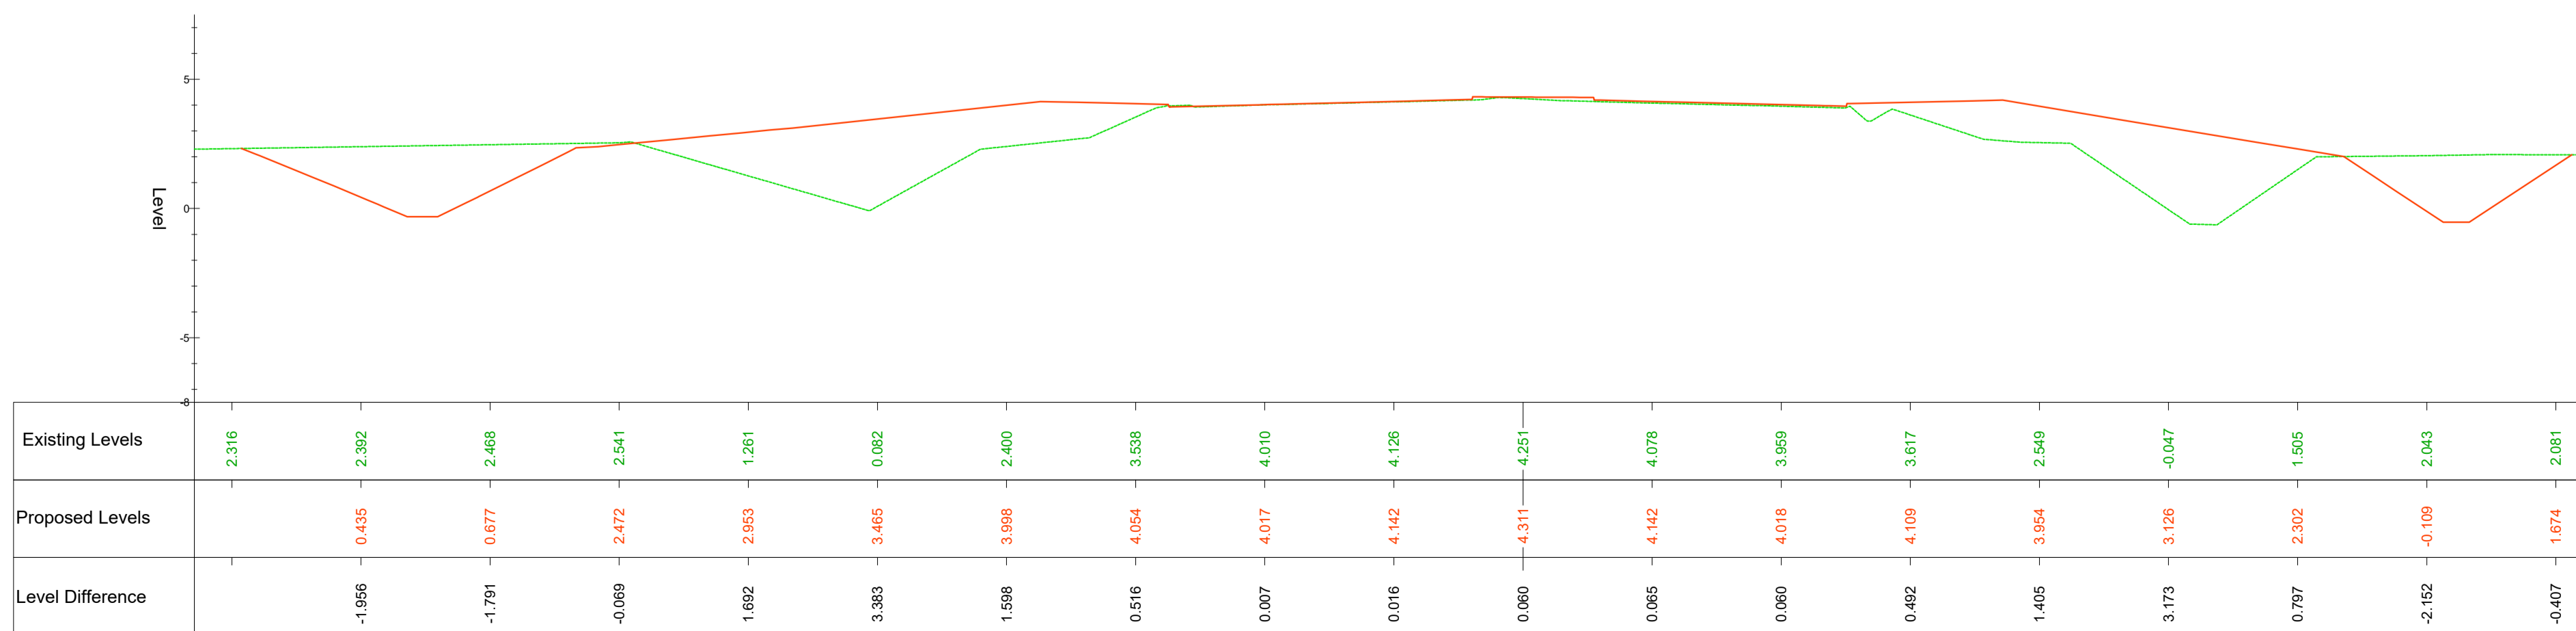

C Roundabout - CL - S Arm - Ch.80.00m

100mm at A1


- NOTES:**
- THIS DRAWING IS TO BE READ IN CONJUNCTION WITH ALL OTHER RELEVANT ENGINEERS AND ARCHITECTS DRAWINGS.
  - DRAWINGS NOT TO BE SCALED.
  - REFER TO DRAWING NUMBER M181-AWP-01-01-DR-D-0321 - CROSS SECTION OVERVIEW FOR SPECIFIC CHAINAGE LOCATION.

**AS-BUILT DRAWING**

THIS DRAWING IS ISSUED FOR INCLUSION IN THE PROJECT AS-BUILT DOCUMENTATION AND THE INFORMATION INDICATED IS, TO THE BEST OF OUR KNOWLEDGE, REPRESENTATIVE OF THE CONSTRUCTED WORKS.

PLEASE NOTE: ALAN WOOD & PARTNERS HAVE NOT CARRIED OUT ANY SITE SUPERVISION OF THE PROJECT DURING CONSTRUCTION. THE CONTRACTOR IS DEEMED TO HAVE INSTALLED THE WORKS IN ACCORDANCE WITH THE CONSTRUCTION ISSUE DRAWINGS. UNLESS NOTED OTHERWISE ON THIS DRAWING OR CONFIRMED SEPARATELY BY THE CONTRACTOR IN WRITING, ALAN WOOD & PARTNERS ACCEPT NO LIABILITY FOR DEVIATIONS BETWEEN THESE DRAWINGS AND THE CONSTRUCTED WORKS. THE RESPONSIBILITY FOR WHICH LIES WHOLLY WITH THE CONTRACTOR.

|                               |          |     |     |     |
|-------------------------------|----------|-----|-----|-----|
| CO2 CONSTRUCTION RECORD ISSUE | 29.08.25 | FM  | JEK | BH  |
| C01 FOR CONSTRUCTION          | 20.05.24 | GDV | BH  | BH  |
| Rev Description               | Date     | By  | Chk | App |

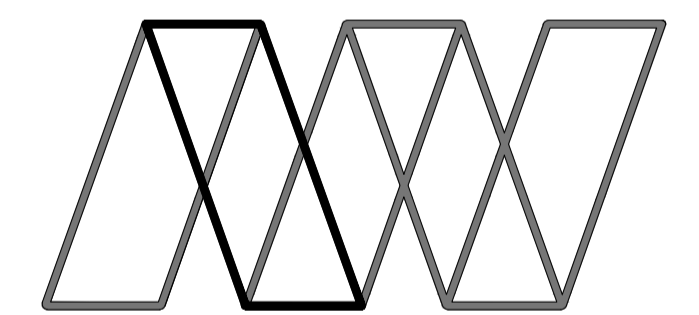

**Alan Wood & Partners**

|  |  |
|--|--|
| <b>York Office</b><br>Omega 2<br>Monks Cross Drive<br>York<br>YO32 9GZ<br><br><b>T. 01904 611594</b><br><a href="http://www.alanwood.co.uk">www.alanwood.co.uk</a> | <b>Consulting Civil &amp; Structural Engineers</b><br><b>Project Managers</b><br><b>Building Surveyors</b><br><br>Hull<br>Lincoln<br>London<br>Scarborough<br>Sheffield<br>Leeds<br><br>T. 01482 442138<br>T. 01522 300210<br>T. 02071 860761<br>T. 01723 865484<br>T. 01142 440077<br>T. 01135 311098 |
|--|--|

|                                      |  |                  |          |      |      |        |
|--------------------------------------|--|------------------|----------|------|------|--------|
| Project:                             | M181/B1450 BURRINGHAM ROAD ROUNDABOUT        |                  |          |      |      |        |
| Client:                              |  |                  |          |      |      |        |
| Drawing:                             | CROSS SECTION - CENTRAL ROUNDABOUT - SHEET 3 |                  |          |      |      |        |
| Role:                                | CIVIL ENGINEER                               |                  |          |      |      |        |
| Drawing Status:                      | CONSTRUCTION RECORD                          |                  |          |      |      |        |
| Job. no.                             | 47603  | Scale@ A1: 1:200 | Rev. C02 |      |      |        |
| Project                              | Originator                                   | Volume           | Level    | Type | Role | Number |
| M181 - AWP - 01 - 01 - DR - D - 0330 |  |                  |          |      |      |        |